1950
MAPS
ERIE
COUNTY
NY

1950 OFFICE MAP

OFFICE COPY 1950

MAP OF
THE TOWN OF
ALDEN
ERIE COUNTY, N.Y.

Compiled by
ERIE COUNTY PLANNING BOARD
1948

#76420

Note: This map is compiled from deeds recorded in the Erie County Clerks Office. Lots of less than one acre are not shown

LEGEND

- COUNTY LINE
- TOWNSHIP & RANGE LINE
- CITY & VILLAGE LINE
- FARM OR GREAT LOT LINE
- PROPERTY LINE
- STATE HIGHWAY
- COUNTY HIGHWAY
- TOWN HIGHWAY
- RAILROADS - Two or more tracks
- STREAMS

SCALE
Feet
0 1000 2000 3000 4000 5000
Miles

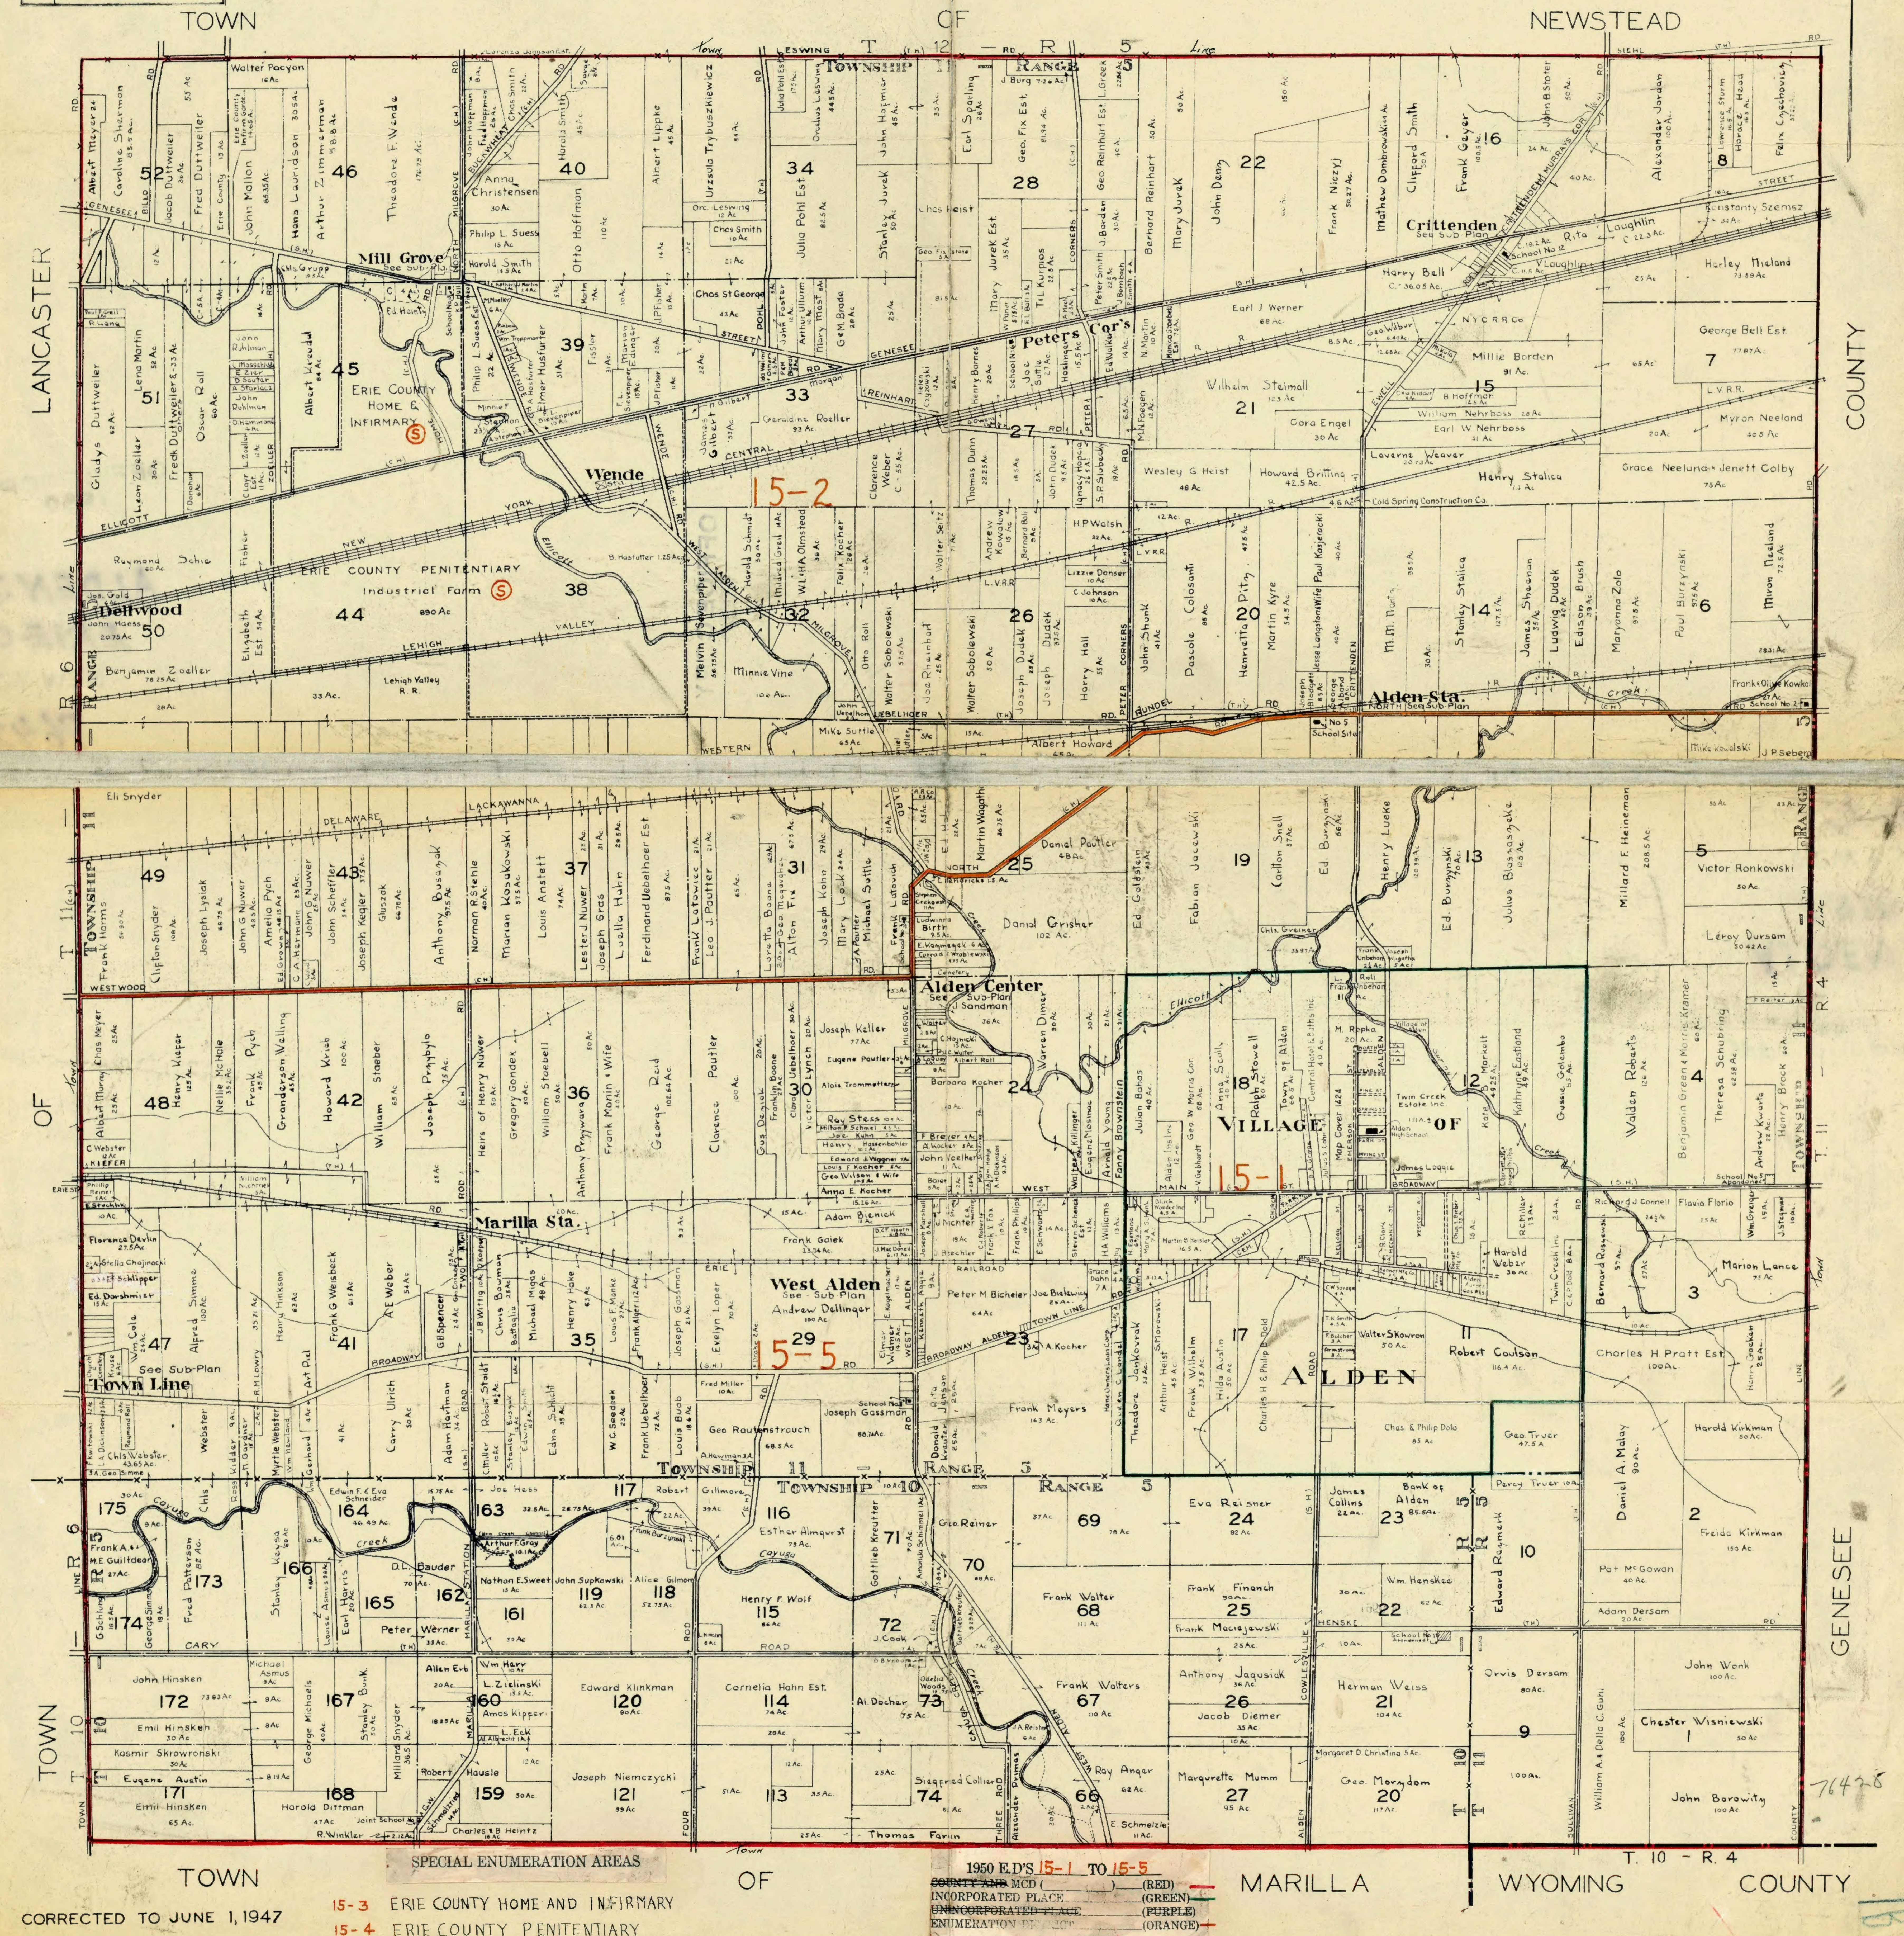

SPECIAL ENUMERATION AREAS

15-3 ERIE COUNTY HOME AND INFIRMARY

15-4 ERIE COUNTY PENITENTIARY

CORRECTED TO JUNE 1, 1947

1950 E.D'S 15-1 TO 15-5
~~COUNTY AND~~ MCD (RED)
INCORPORATED PLACE (GREEN)
~~UNINCORPORATED PLACE~~ (PURPLE)
ENUMERATION DISTRICT (ORANGE)

76420

76420

PARTLY WITHIN BUFFALO URBANIZED AREA –

1950 OFFICE MAP

OFFICE COPY 1950

MAP OF
THE TOWN OF
AMHERST
ERIE COUNTY, N.Y.

Reproduced by
ERIE COUNTY PLANNING BOARD
1948

76429

LEGEND

COUNTY LINE	▬ ▪ ▬
TOWNSHIP & RANGE LINE	–×–––×–
CITY & VILLAGE LINE	–··–··–
FARM OR GREAT LOT LINE	––·––
PROPERTY LINE	–––
STATE HIGHWAY	MAIN (S.H.) ST.
COUNTY HIGHWAY	FRENCH (C.H.) RD.
TOWN HIGHWAY	NEW (T.H.) RD.
RAILROADS SINGLE	┼┼┼┼
RAILROADS DOUBLE	╪╪╪╪
POWER LINE	⌃ ⌃ ⌃
WATER	
PARKS	▭

NOTE: This map is compiled from deeds recorded in the Erie County Clerks Office, surveys and other available data.

1950 E.D'S 15-6 TO 15-36
~~COUNTY AND~~ MCD (RED)
INCORPORATED PLACE (GREEN)
~~UNINCORPORATED PLACE~~ ~~(PURPLE)~~
ENUMERATION DISTRICT (ORANGE)
CENSUS TRACT (BROWN)
URBANIZED AREA (YELLOW)

SPECIAL ENUMERATION AREAS
15-25 CONVENT OF SISTERS OF ST FRANCIS OF PENANCE AND CHRISTIAN CHARITY (SACRED HEART ACADEMY)
15-27 METHODIST HOME FOR CHILDREN
15-29 ST MARY OF THE ANGELS MOTHERHOUSE AND NOVITIATE OF SISTERS OF THE THIRD ORDER OF ST FRANCIS INCLUDING HOME FOR AGED

Urbanized Area boundary
[illegible]
R. F. Kingsley

COPYRIGHT 193[illegible] NIAGARA FRONTIER PLANNING BOARD

OFFICE COPY 1950

1950 OFFICE MAP

MAP OF
THE TOWN OF
AURORA
ERIE COUNTY, N.Y.

Compiled by

ERIE COUNTY PLANNING BOARD

1948

NOTE: This map is compiled from deeds recorded in the Erie County Clerks Office Lots of less than one acre are not shown.

LEGEND

- TOWNSHIP & RANGE LINE
- CITY & VILLAGE LINE
- FARM GREAT LOT LINE
- PROPERTY LINE
- STATE HIGHWAY — CENTER (S.H.) ST
- COUNTY HIGHWAY — GROVER (C.H.) RD
- TOWN HIGHWAY — BAILEY (T.H.) RD
- RAILROADS
- STREAMS
- PARKS

SCALE

Feet: 1000 0 1000 2000 3000 4000 5000

Miles: 0 ¼ ½ ¾ 1

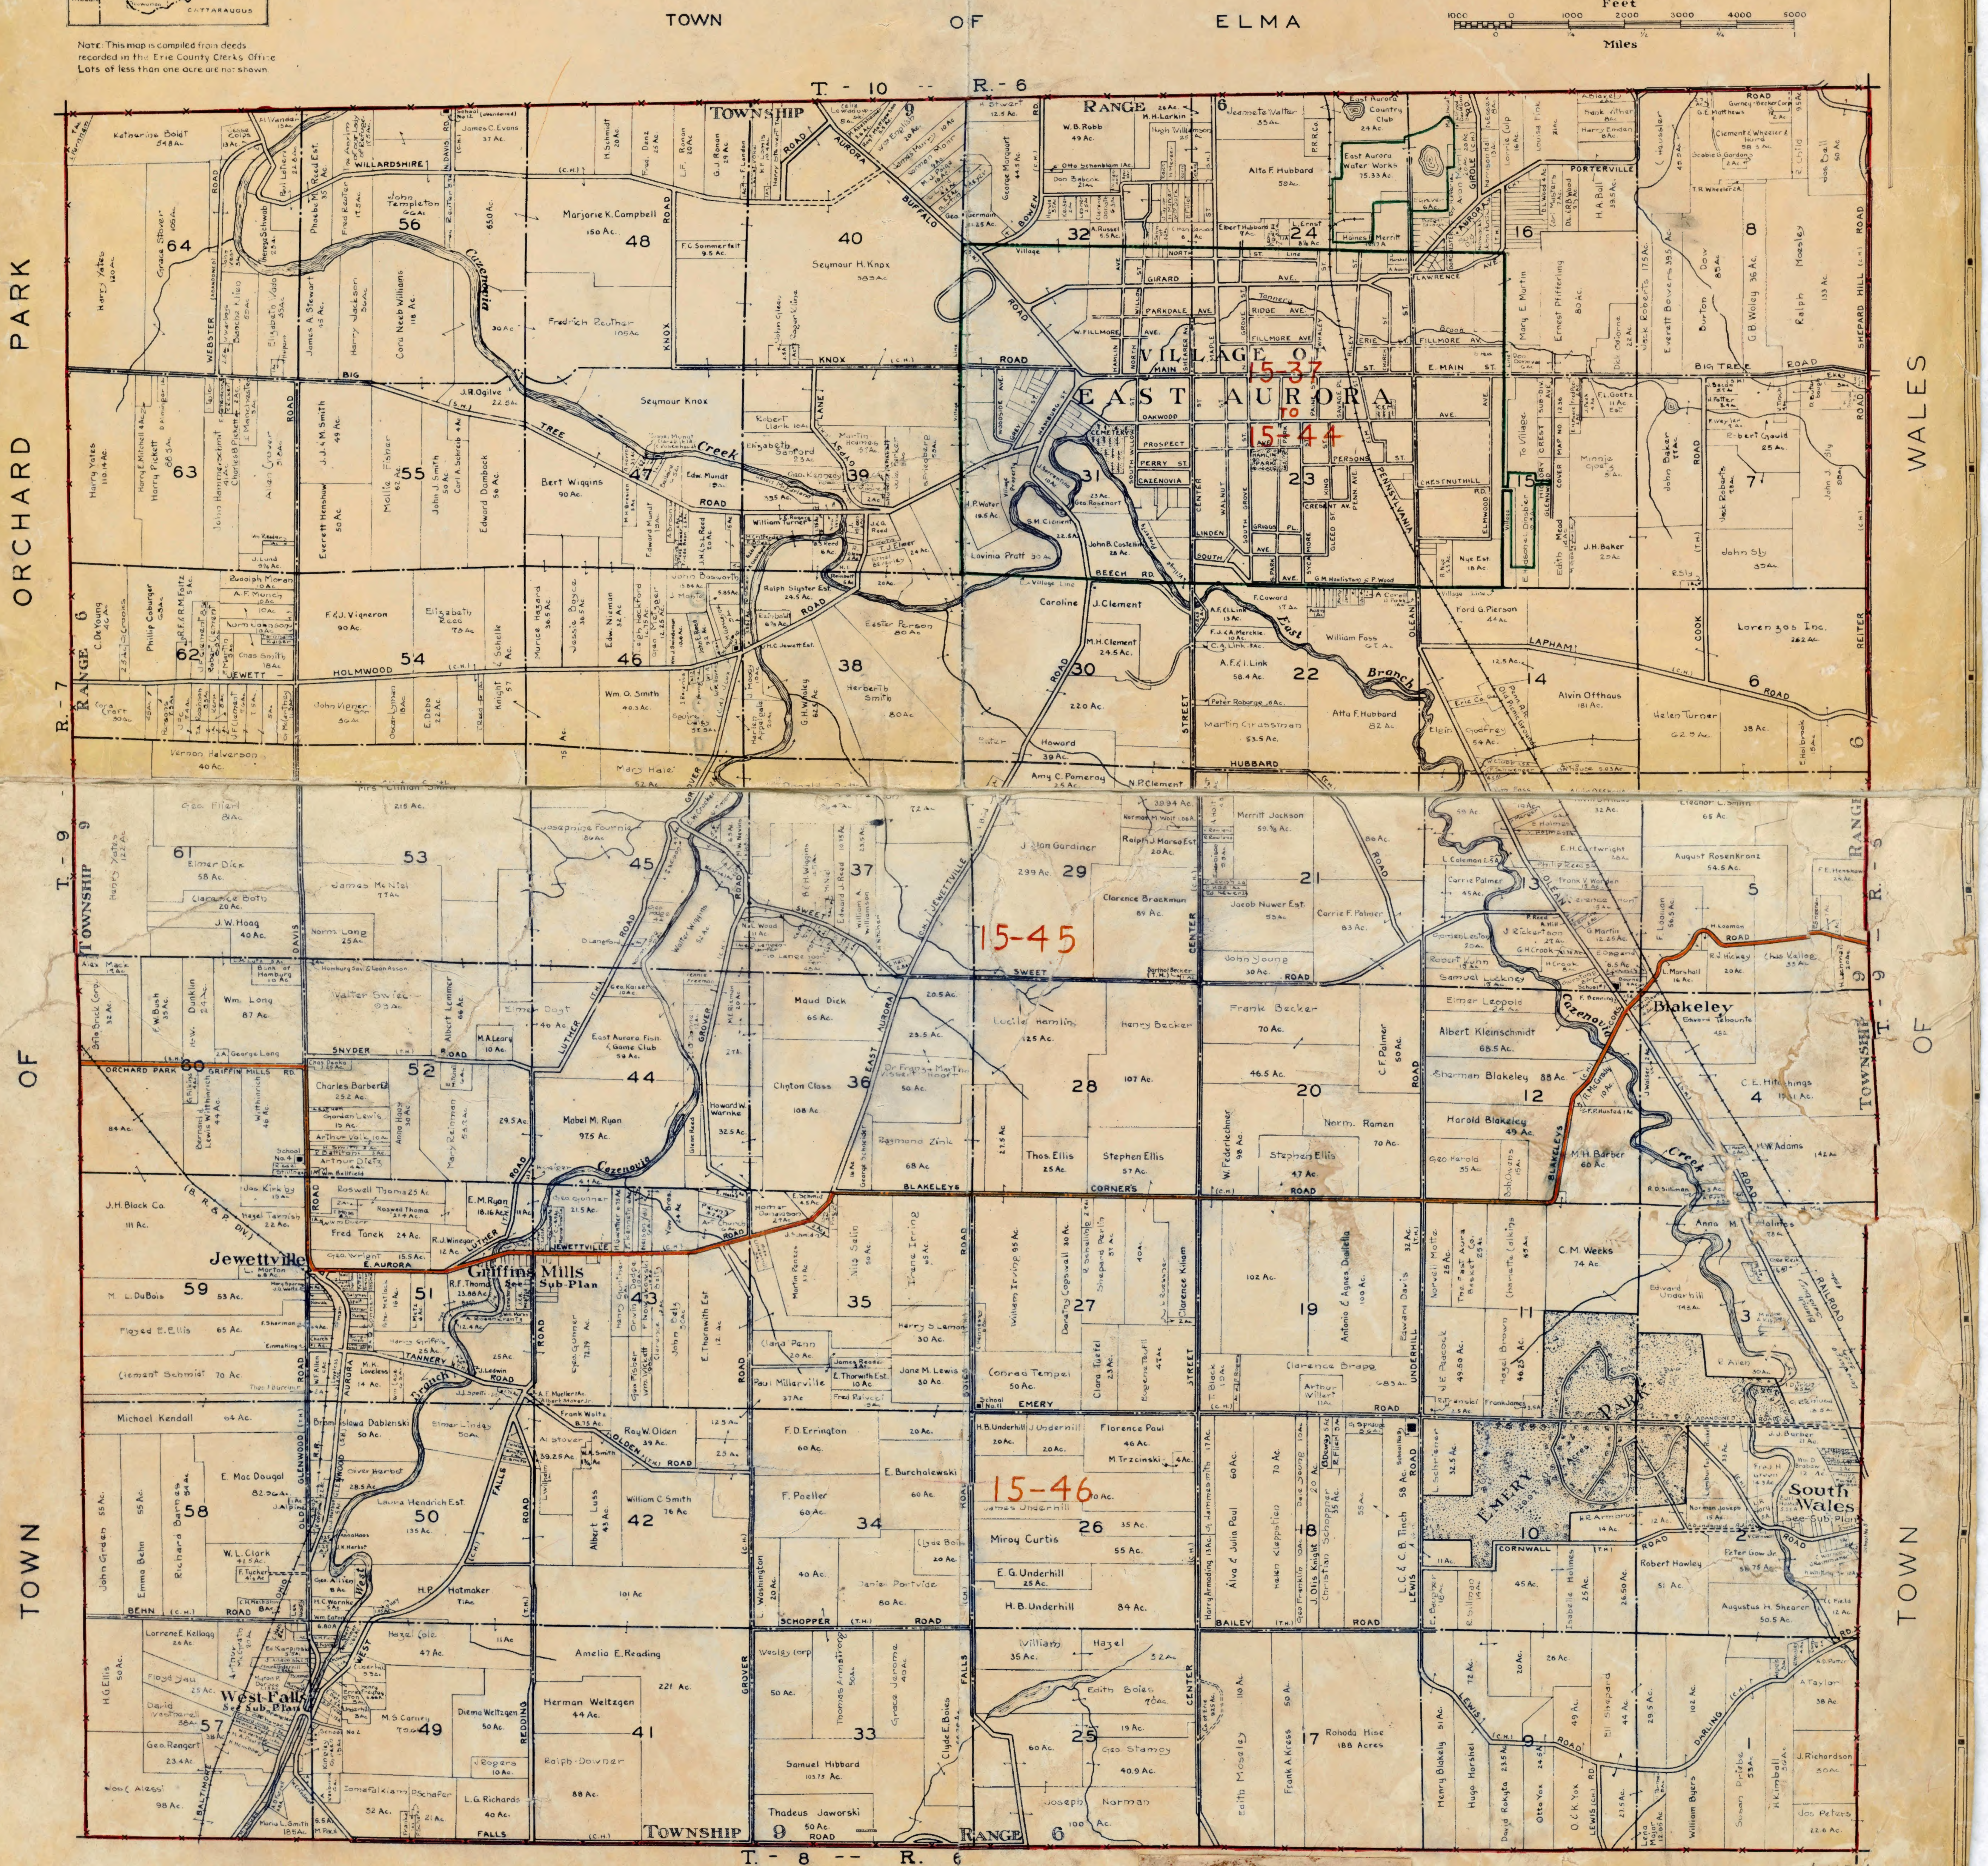

1950 E.D'S 15-37 TO 15-46
~~COUNTY AND~~ MCD (______)____(RED)
INCORPORATED PLACE________(GREEN)
~~UNINCORPORATED PLACE~~________(~~PURPLE~~)
ENUMERATION DISTRICT________(ORANGE)

76431

Corrected Through Jan. 1948

ENTIRELY WITHIN BUFFALO URBANIZED AREA

1950 OFFICE MAP

SPECIAL ENUMERATION AREAS

65-44 MOTHERHOUSE OF THE SISTERS OF MERCY INCLUDING MOUNT MERCY ACADEMY
65-107 BUFFALO HOTEL
65-118 U. S. COAST GUARD BASE
65-142 500 CLINTON ST. APARTMENTS
65-161 LAFAYETTE HOTEL
65-267 CONVENT OF SISTERS OF ST. FRANCIS OF PENANCE AND CHRISTIAN CHARITY
65-272 CONVENT OF THE SISTERS OF THE THIRD ORDER OF ST. FRANCIS INCLUDING ST. FRANCIS ASYLUM
65-313 MONASTERY OF THE DOMINICAN NUNS OF THE PERPETUAL ROSARY
65-351 MONASTERY OF SISTERS OF OUR LADY OF CHARITY OF REFUGE
65-367 ROSWELL PARK MEMORIAL INSTITUTE
65-369 ROOSEVELT APARTMENTS
65-372 CONVENT OF DAUGHTERS OF CHARITY OF ST. VINCENT DE PAUL INCLUDING ST. MARY'S INFANT ASYLUM AND MATERNITY HOSPITAL
65-380 MARKEEN HOTEL
65-422 CONVENT OF THE THIRD ORDER OF ST. FRANCIS INCLUDING GERMAN ROMAN CATHOLIC ORPHAN HOME
65-492 EDWARD J. MEYER MEMORIAL HOSPITAL
65-548 U. S. VETERAN'S ADMINISTRATION HOSPITAL
65-617 CONVENT OF SISTERS OF ST. JOSEPH INCLUDING ST. MARY'S SCHOOL FOR THE DEAF
65-618 U. S. MARINE HOSPITAL
65-625 MOTHERHOUSE OF SISTERS OF ST. JOSEPH INCLUDING MOUNT ST. JOSEPH ACADEMY AND SCHOOL
65-719 BUFFALO STATE HOSPITAL
65-743 PARK LANE APARTMENTS
65-747 WEST FERRY ST. APARTMENTS
65-757 STRATFORD ARMS HOTEL
65-767 CAMPANILE APARTMENTS
65-775 MISSIONARY SISTERS OF THE DIVINE CHILD
65-781 AMBASSADOR APARTMENTS
65-782 STUYVESANT HOTEL
65-784 SHERATON HOTEL
65-789 LENOX HOTEL
65-800 TUDOR ARMS HOTEL
65-827 CONVENT OF GREY NUNS OF THE SACRED HEART INCLUDING D'YOUVILLE COLLEGE
65-868 GRAYSTONE HOTEL
65-869 TOURAINE HOTEL
65-871 MILNER HOTEL
65-872 RICHFORD HOTEL
65-874 STATLER HOTEL
65-876 RYAN'S – NIAGARA HOTEL
65-877 WORTH HOTEL

LEGEND

CITY LIMIT AND WARD LINE ---- GREEN
E.D. BOUNDARY AND NUMBER ---- ORANGE
TRACT BOUNDARY ------------
TRACT NUMBER ------------ ⑦
SEPARATE E.D'S ------------ Ⓢ
ALL E.D. NUMBERS PRECEDED BY -- 65
E.D.S 65-1 TO 65-880
CONGRESSIONAL DISTRICT LINES — BLUE

CITY OF
BUFFALO
ERIE CO., NEW YORK

SCALE
750 0 750 1500 2250 FT

COMPILED FROM CITY ENGINEER'S MAP AND SANBORN VOLS. 027 THRU 034, 036 AND 037

CORPORATE LIMITS

COMPILED BY M. BESTUL APRIL 22, 1949

BUREAU OF THE CENSUS

DUPLICATE COPY OF ORIGINAL 1950 OFFICE MAP PREPARED BY A. N. BRIGHT
VERIFIED TO ORIGINAL 1950 OFFICE MAP AND E.D. DESCRIPTIONS BY D.E. CULBERTSON 4-–-51
COPY MADE MAR 7, 1951

CHECKED TO SANBORN – JAS. GORDON – 4-29-49 TRACTS + BLOCKS NUMBERS – JAS. T. GORDON – 5-12-49 CHECKED TRACTS + BLOCK NUMBERS – W. H. GORDON – 5-31-49 VERIFIED – W. GEORGE – 7-15-49 INKED NUMBERS + TRACTS VERIFIED – W. GEORGE – 8-8-49 REVIEW – S. DONDERO – 8-8-49

101190

PARTLY WITHIN BUFFALO URBANIZED AREA

1950 OFFICE MAP

OFFICE COPY 1950

MAP OF
THE TOWN OF
CHEEKTOWAGA
ERIE COUNTY, N.Y.

Reproduced by
ERIE COUNTY PLANNING BOARD
1948

76425

NOTE: This map is compiled from deeds recorded in the Erie County Clerks Office, surveys and other available data.

··· LEGEND ···

TOWNSHIP & RANGE LINE	—x——x—
CITY & VILLAGE LINE	——··——
FARM & GREAT LOT LINE	—·——·—
PROPERTY LINE	——
STATE HIGHWAY	GENESEE (S.H.) ROAD
COUNTY HIGHWAY	CLEVELAND (C.H.) DRIVE
TOWN HIGHWAY	HUTH (T.H.) ROAD
STREAMS	

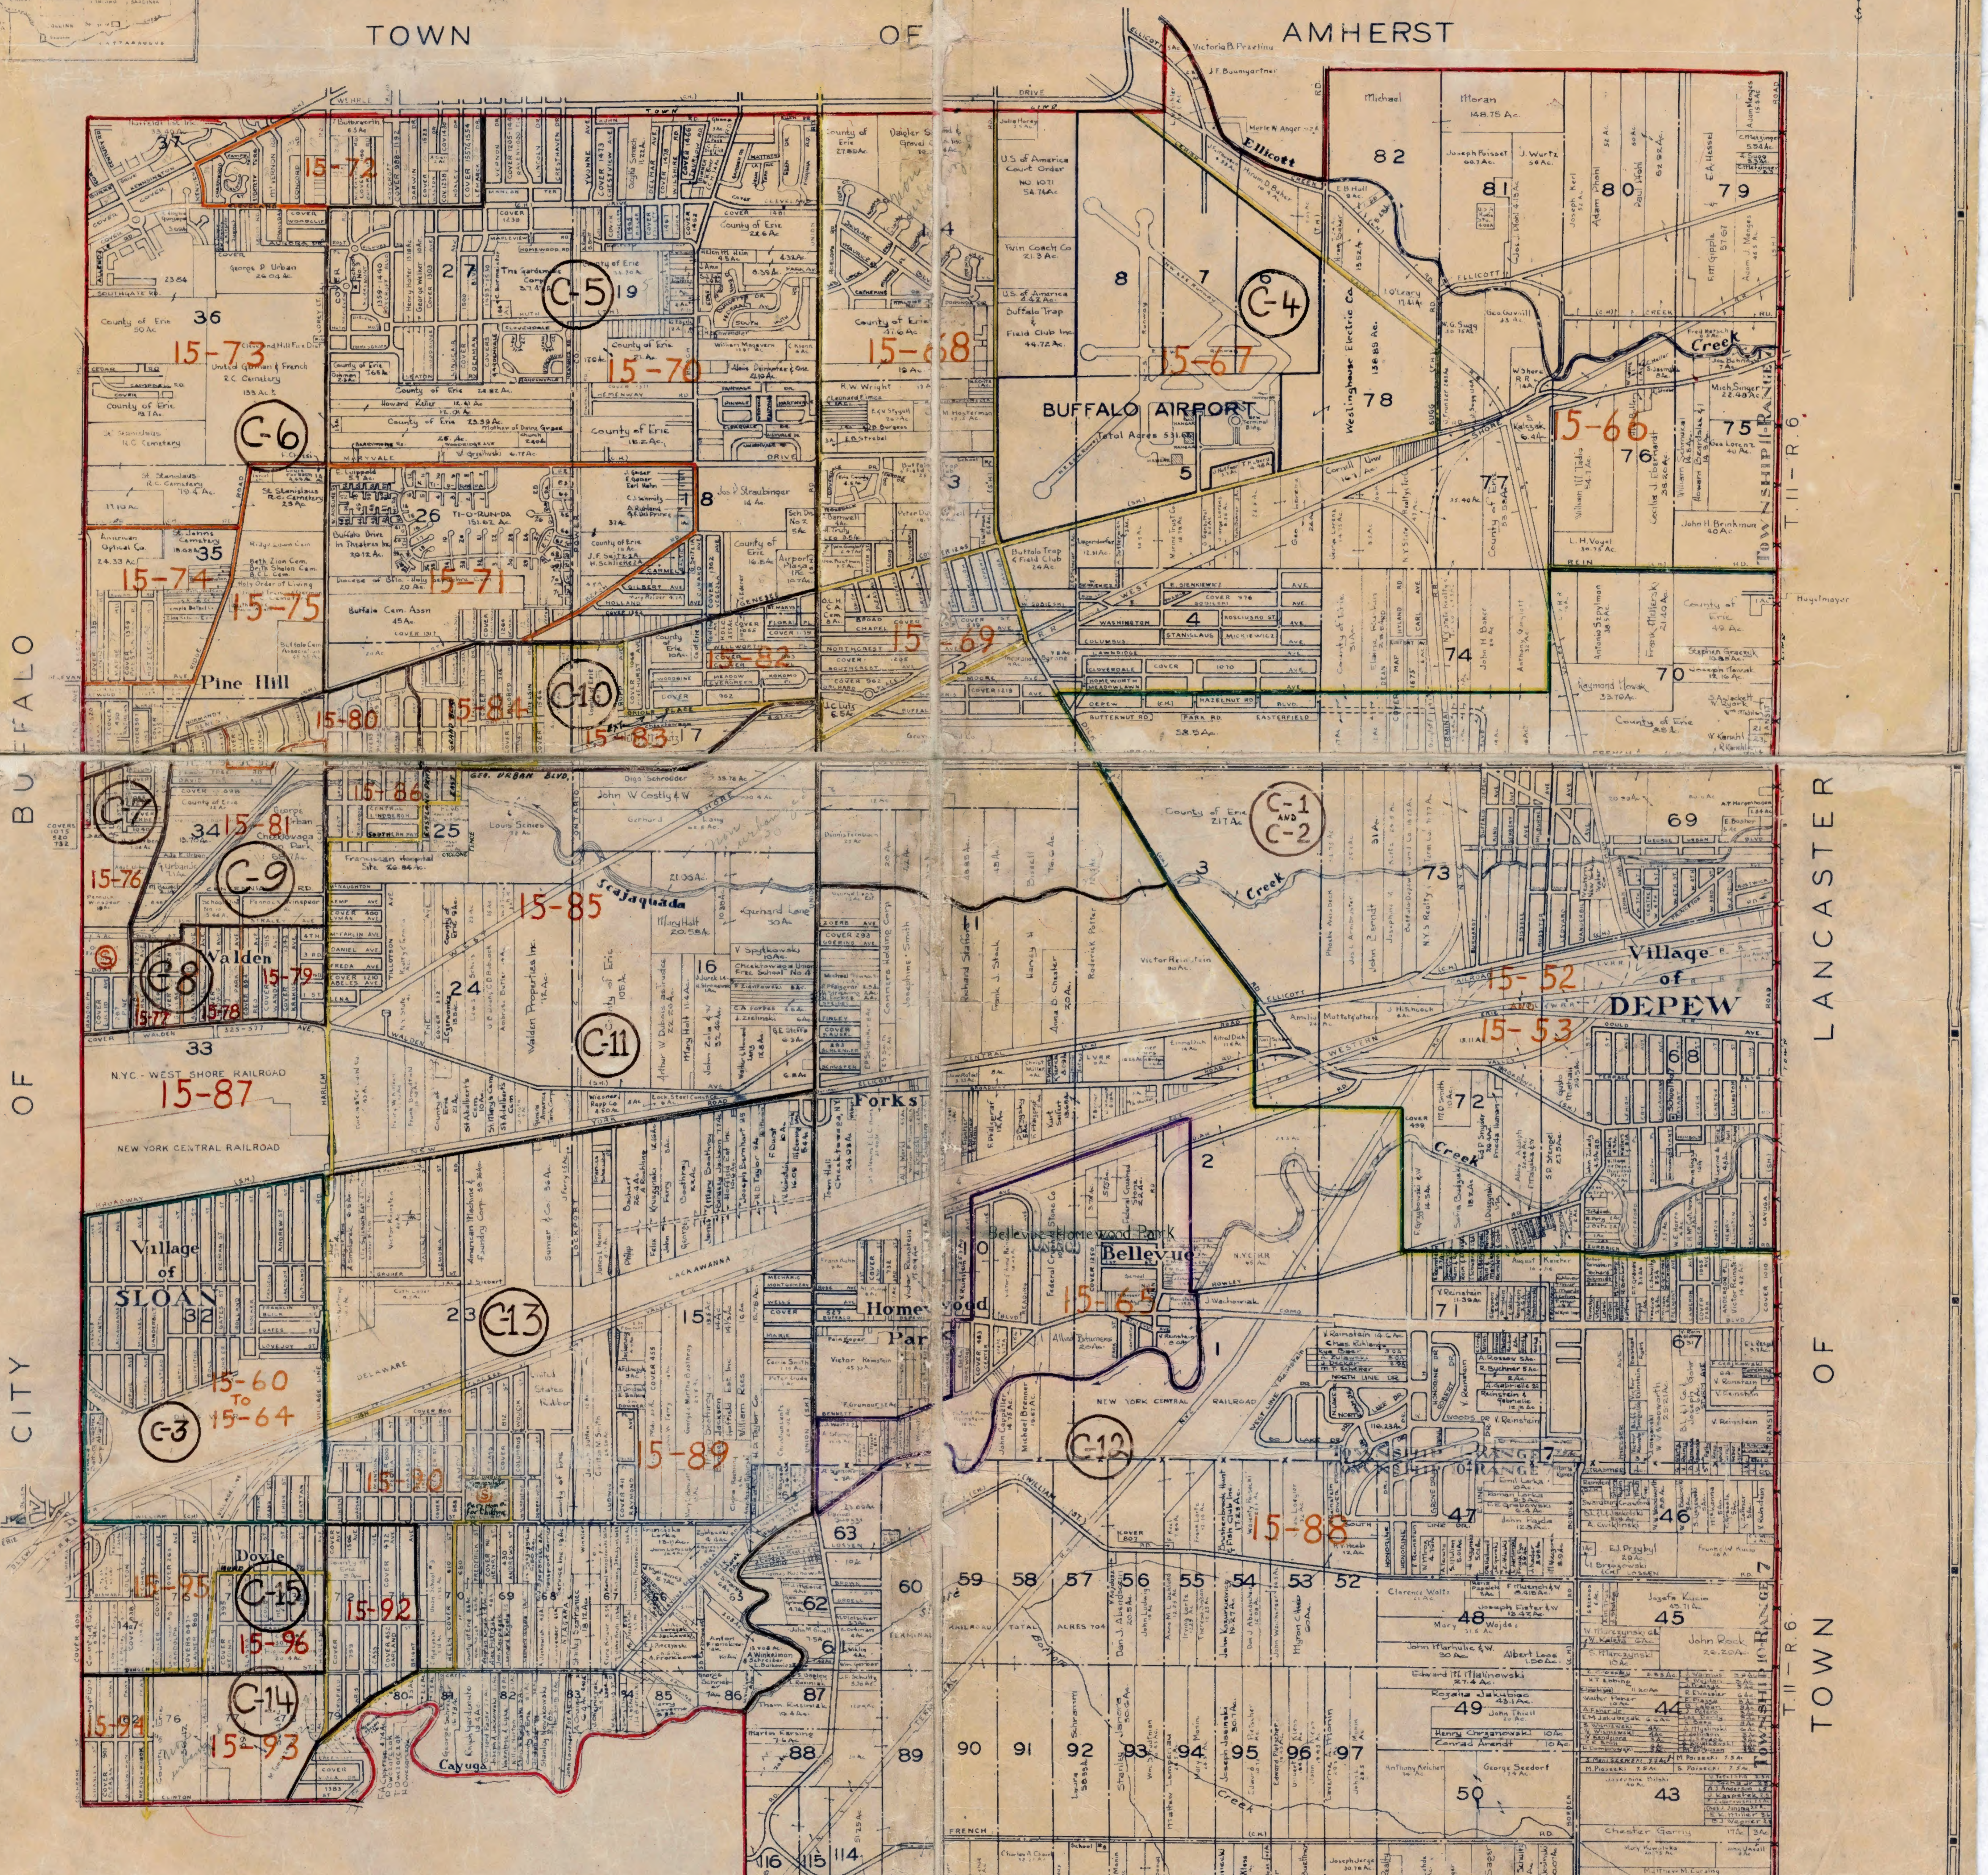

SCALE
Feet
0 1000 2000 3000 4000 5000
Miles
0 1/8 1/4 3/4 1 Mile

NOTE: This map has been Reproduced through the courtesy of the Town of Cheektowaga from their official map.

Urbanized Area boundary
Reviewed and Approved
6/30/50 John K. Kim
R. L. Wrigley

CORRECTED TO JAN 1, 1948

SPECIAL ENUMERATION AREAS

15-91 CONVENT OF FELICIAN SISTERS O.S.F.
INCLUDING
IMMACULATE HEART OF MARY HOME FOR CHILDREN
15-254 PROVINCIAL MOTHERHOUSE OF FELICIAN SISTERS O.S.F.
INCLUDING
IMMACULATE HEART OF MARY ACADEMY "VILLA MARIA"

1950 E.D'S 15-52 AND 15-53 15-60 TO 15-96 AND 15-254

~~COUNTY AND MCD~~ (TOWN)	(RED)
INCORPORATED PLACE	(GREEN)
UNINCORPORATED PLACE	(PURPLE)
ENUMERATION DISTRICT	(ORANGE)
CENSUS TRACT ⓒ	(BROWN)
URBANIZED AREA	(YELLOW)

76425

1950 OFFICE MAP

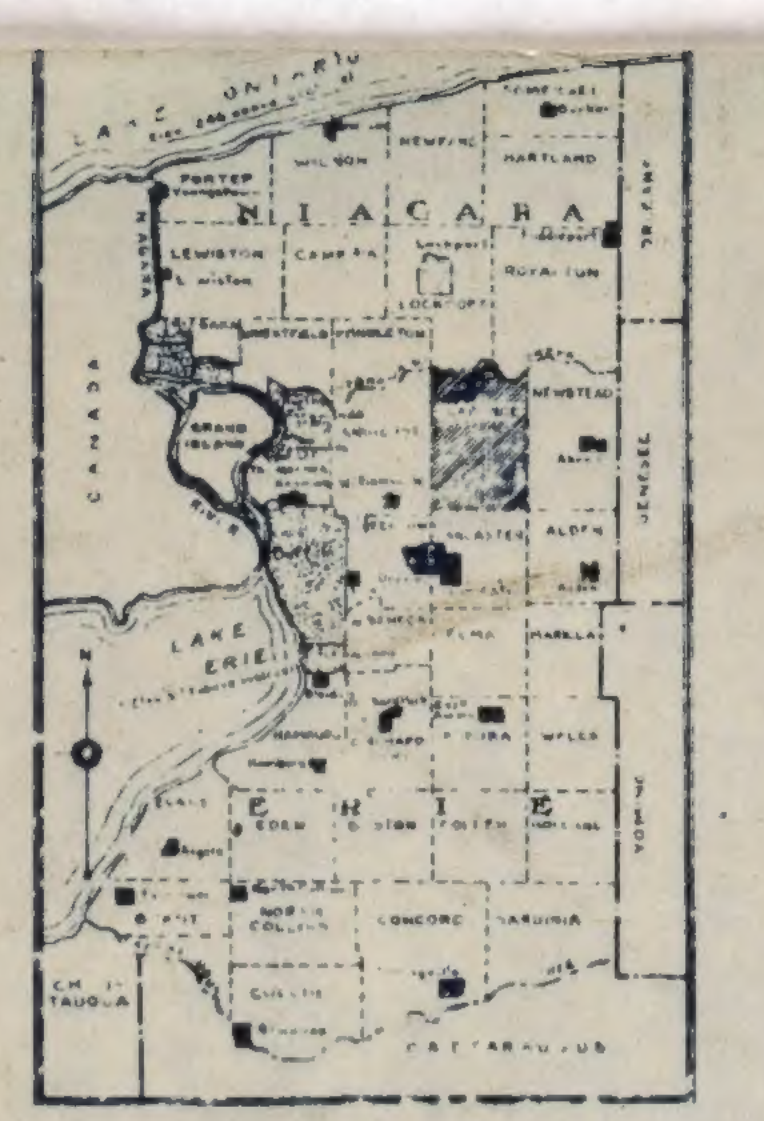

MAP OF
THE TOWN OF
CLARENCE
ERIE COUNTY, N. Y.

Compiled by

ERIE COUNTY PLANNING BOARD

1948

NOTE: This map is compiled from deeds recorded in the Erie County Clerks Office, surveys and other available data.

SCALE

Feet

0 1000 2000 3000 4000 5000

0 ½ ¼ ½ ¾ 1

Miles

76422

·•· LEGEND ·•·

COUNTY LINE

TOWNSHIP & RANGE LINE

FARM OR GREAT LOT LINE

PROPERTY LINE

STATE HIGHWAY — SHERIDAN (S.H.) DR.

COUNTY HIGHWAY — LAPP (C.H.) RD.

TOWN HIGHWAY — BALT (T.H.) RD.

SECTION LINE

STREAMS

WORKS PROGRESS ADMINISTRATION
MAPPING PROJECT
SPONSORED BY
ERIE COUNTY BOARD OF SUPERVISORS

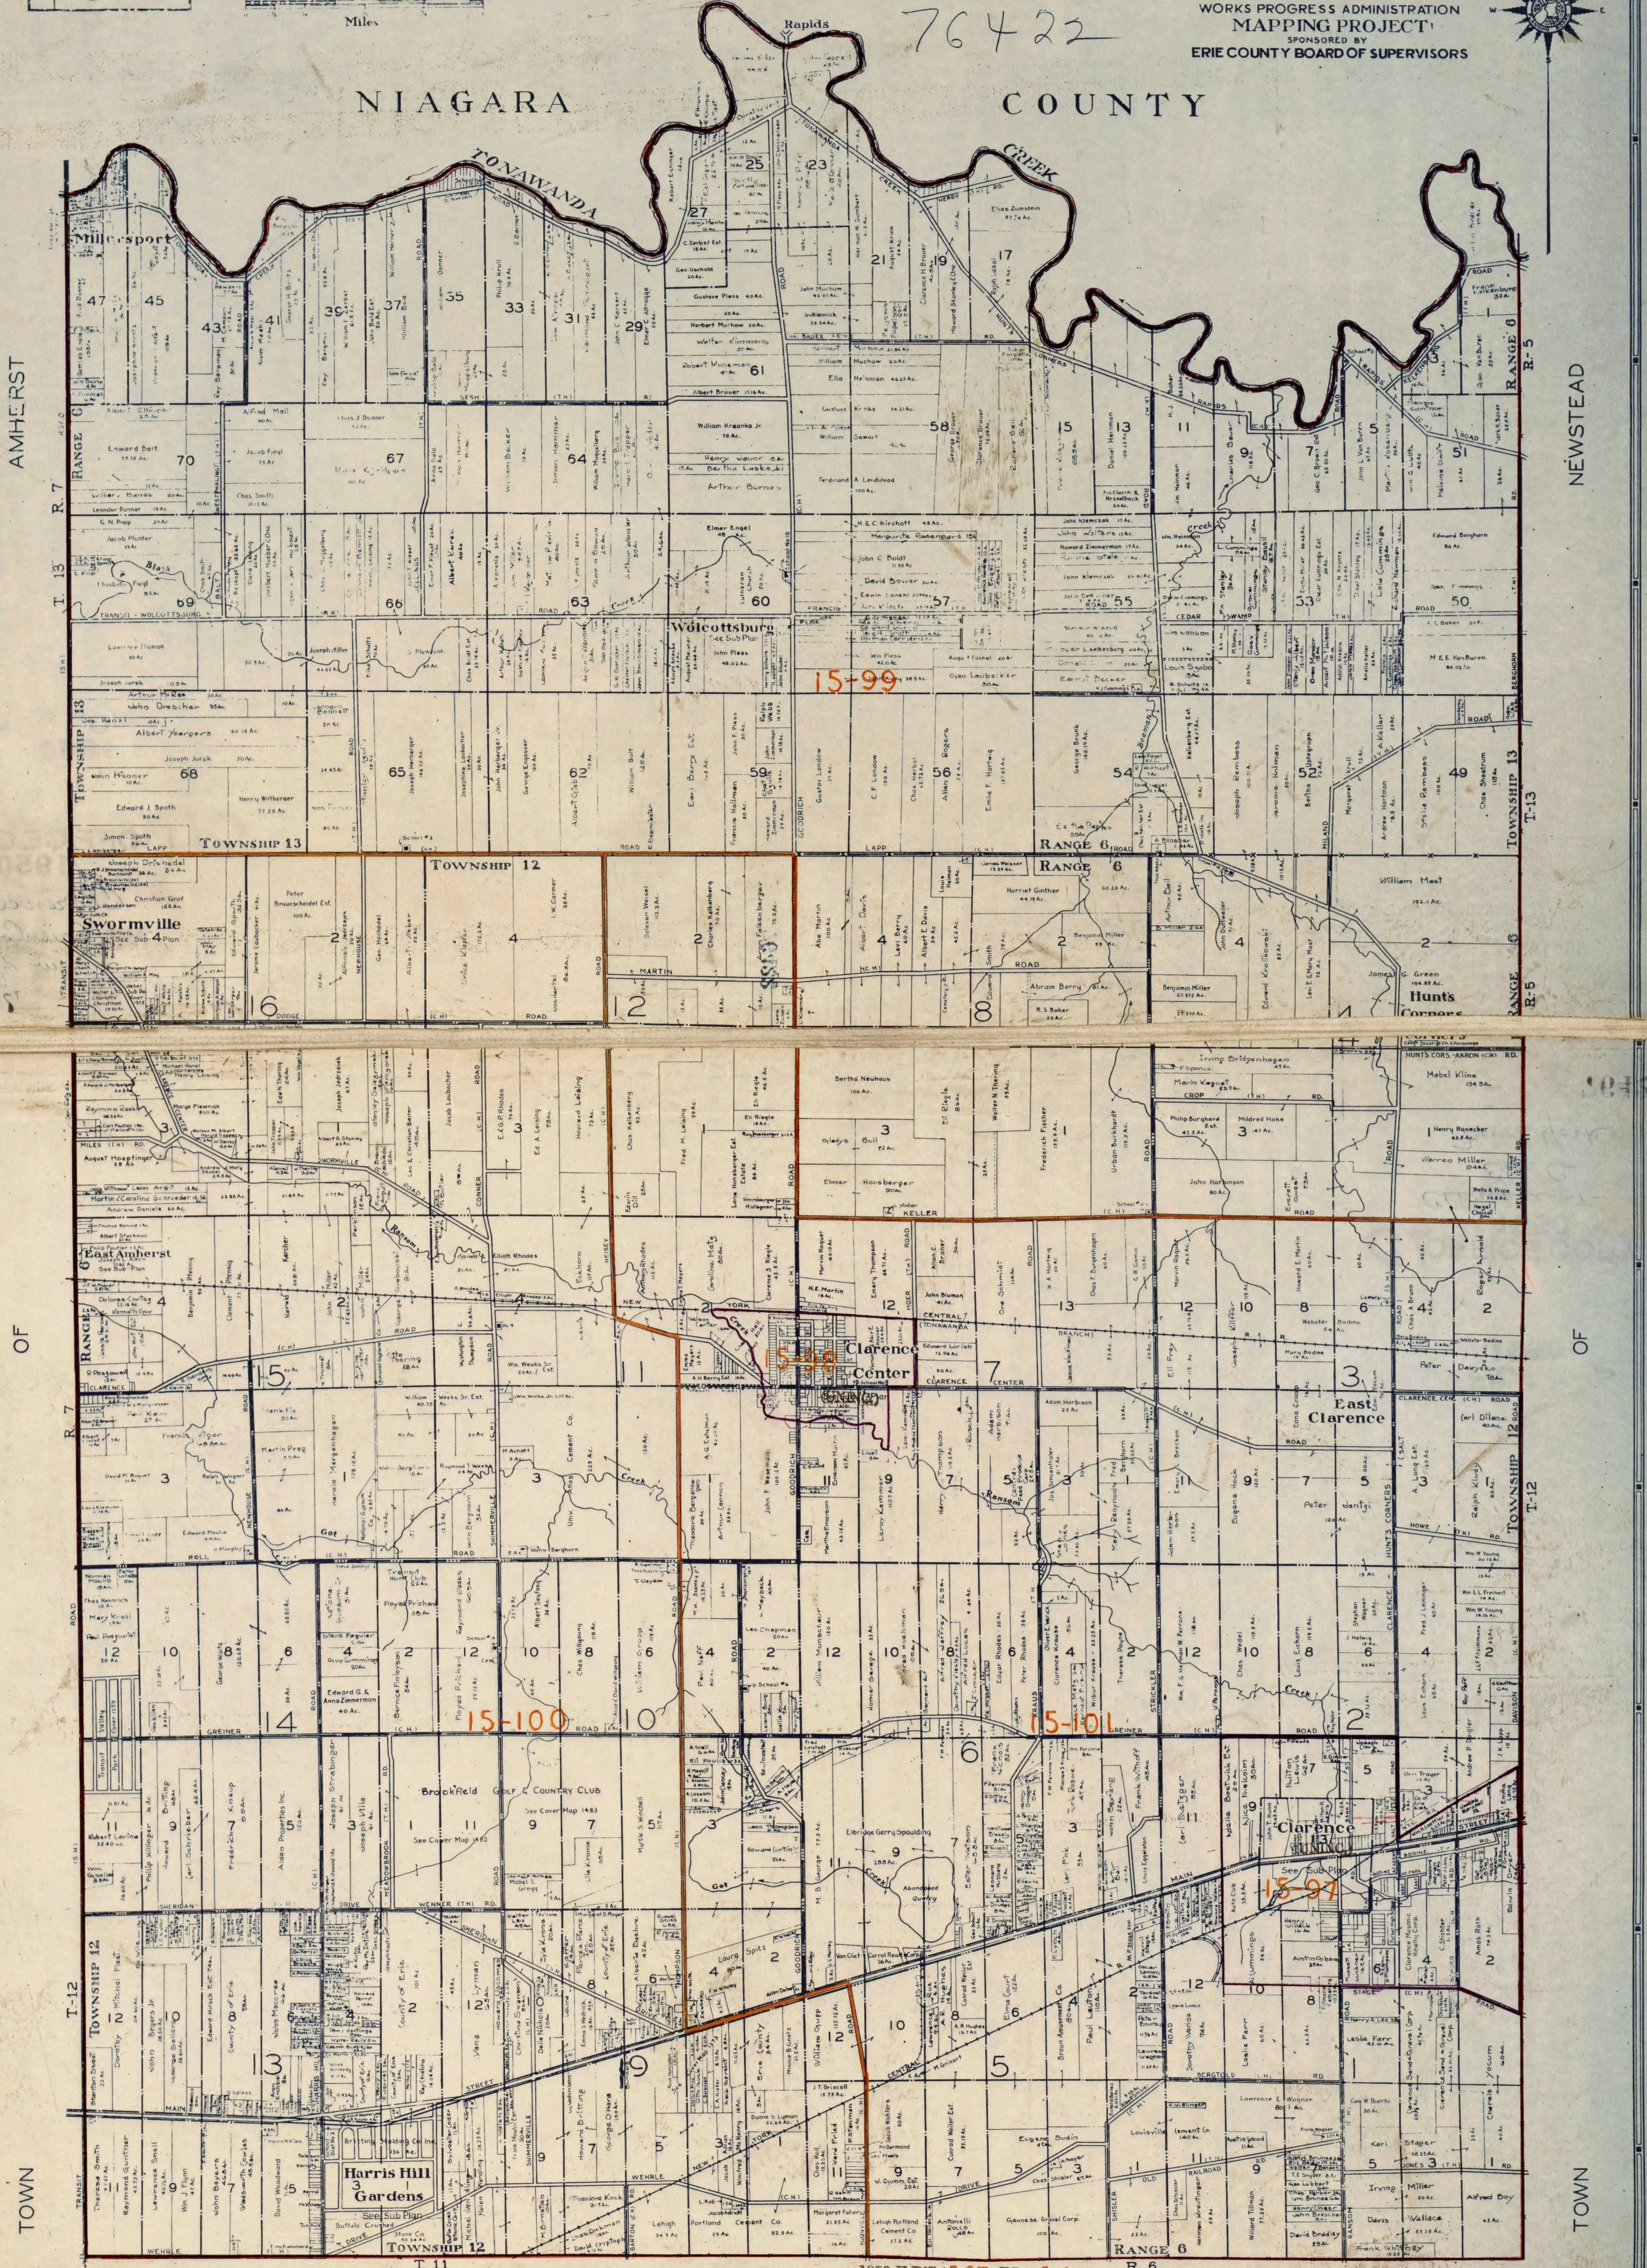

DUPLICATE COPY OF ORIGINAL 1950 OFFICE MAP PREPARED BY Muir
VERIFIED TO ORIGINAL 1950 OFFICE MAP & E.D. DESCRIPTIONS BY Henderson
DATE COPY WAS MADE 7-28-61

1950 E.D'S 15-97 TO 15-101

MCD (______________) ______(RED)
UNINCORPORATED PLACE ______(PURPLE)

76422

TOWN OF LANCASTER

1950 OFFICE MAP

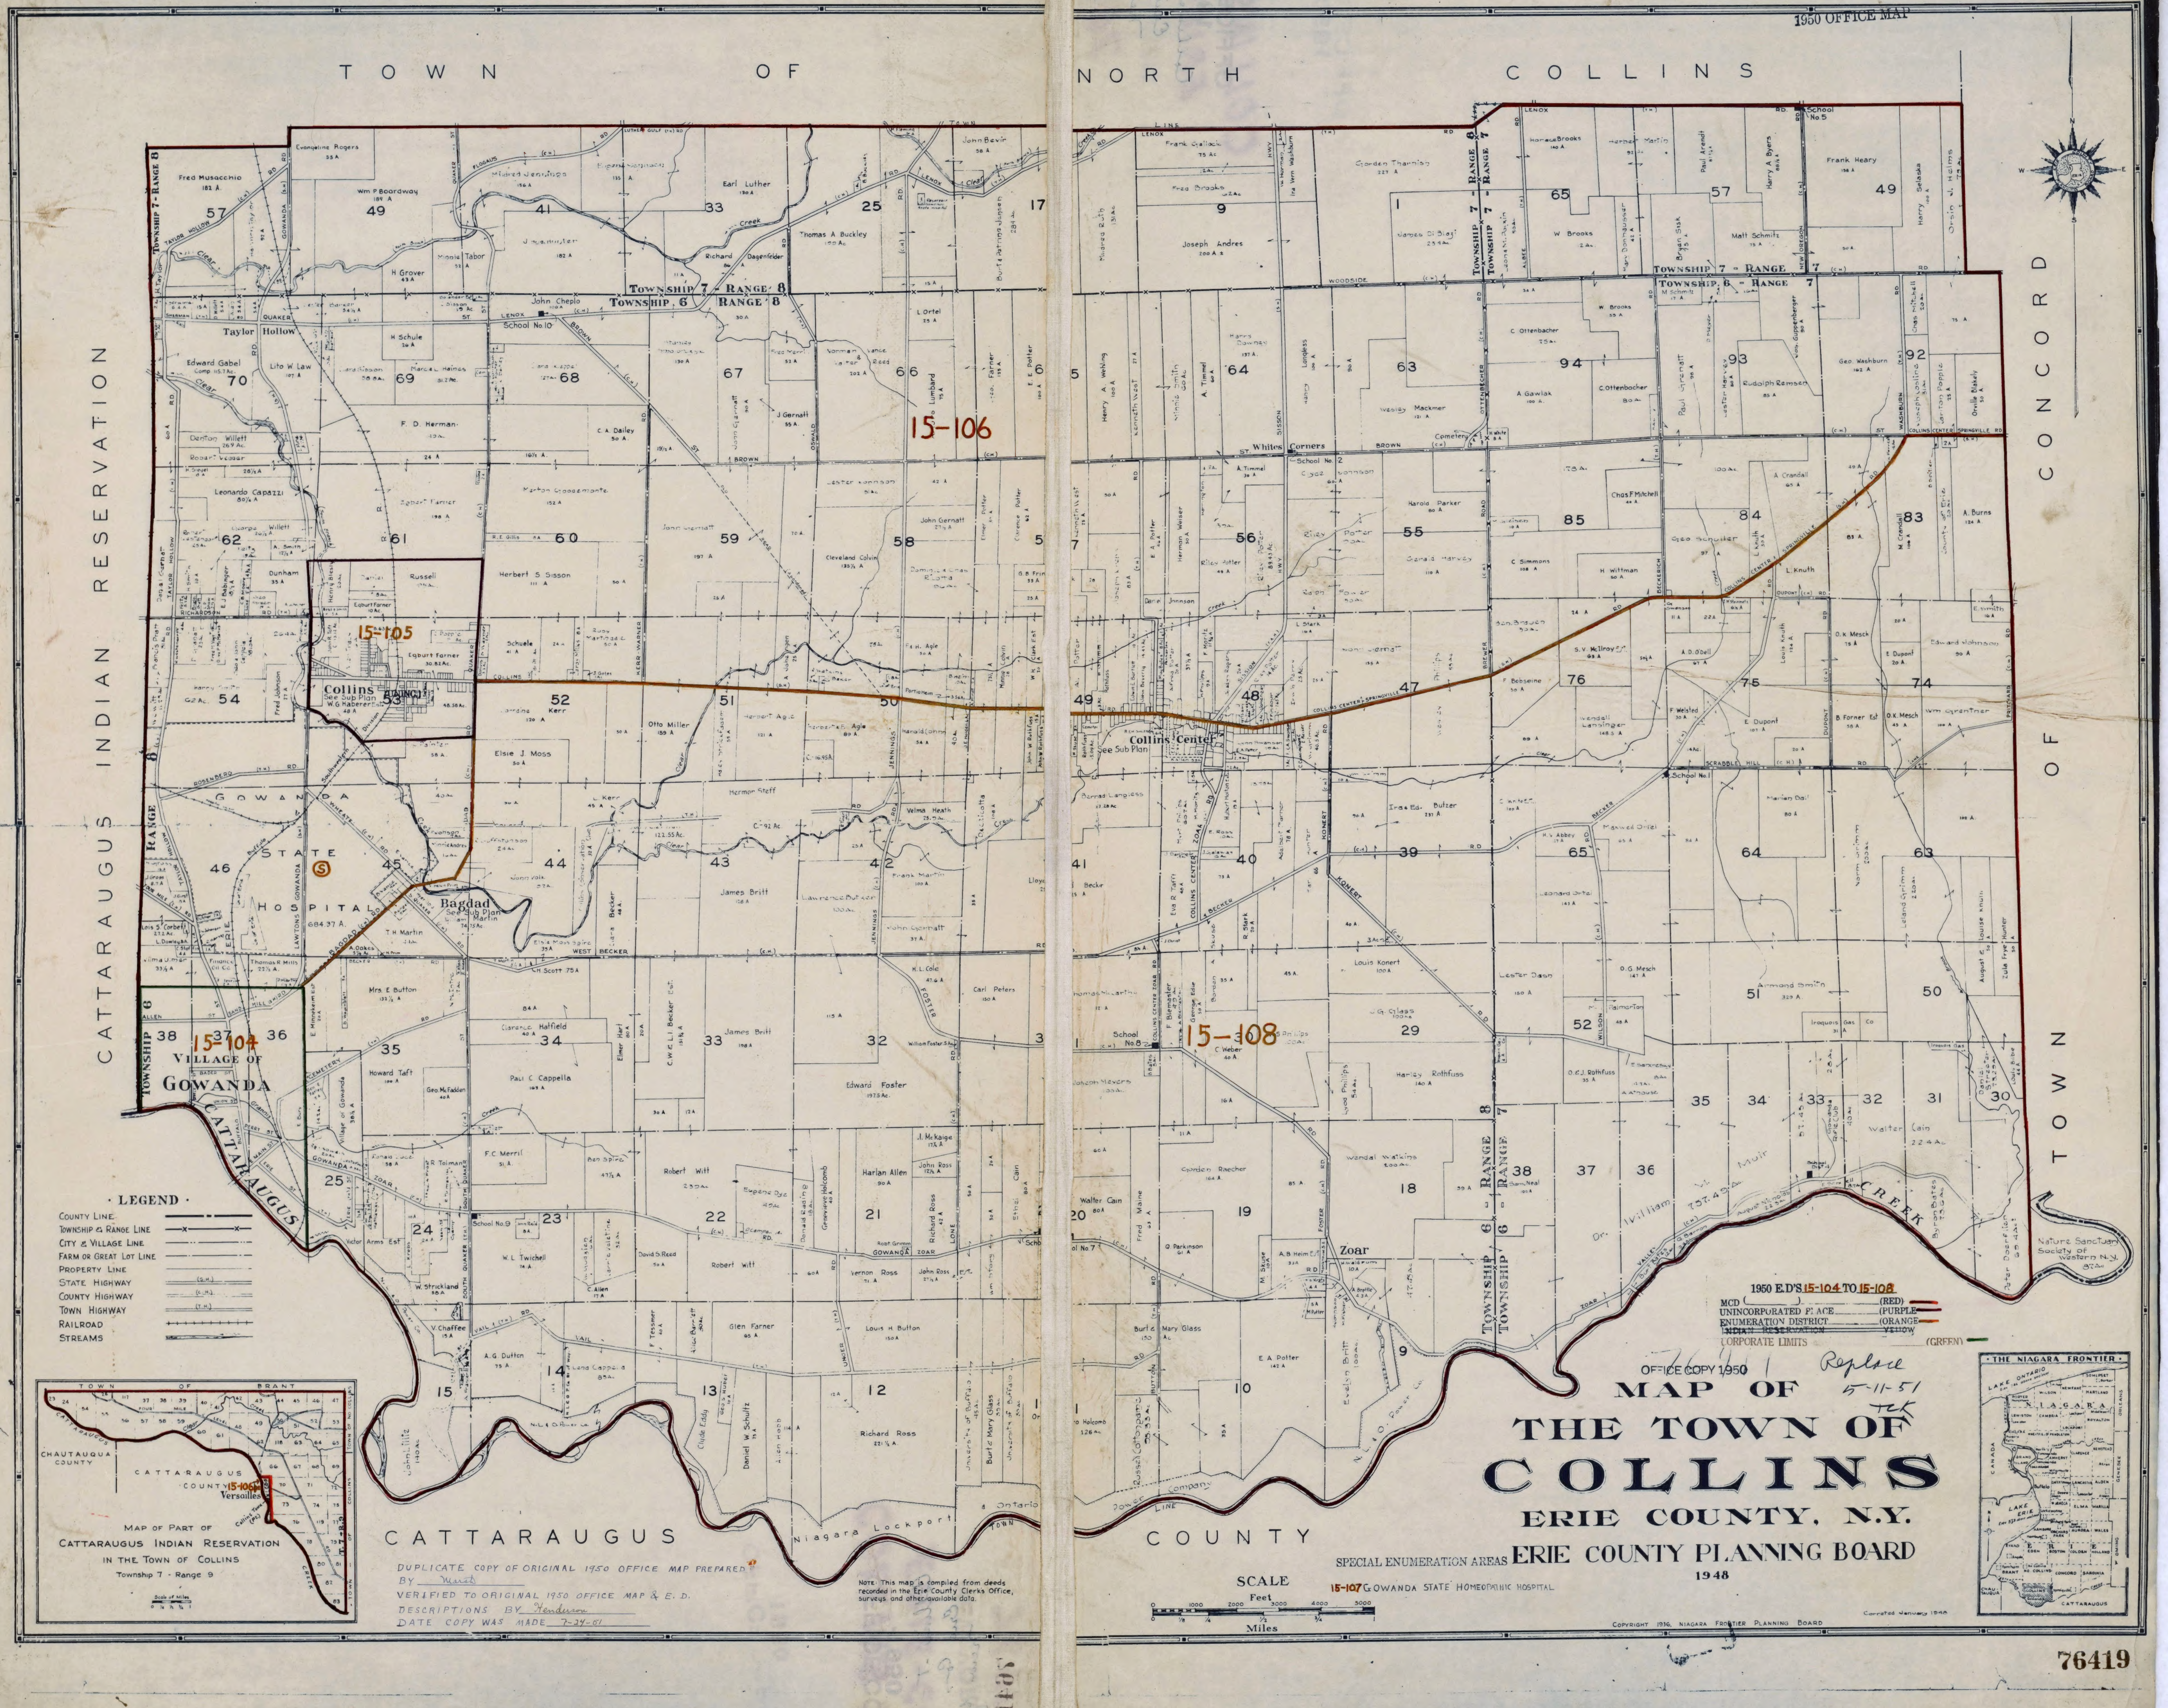

1950 E.D'S 15-104 TO 15-108
MCD ( )(RED)
UNINCORPORATED PLACE (PURPLE
ENUMERATION DISTRICT (ORANGE
~~INDIAN RESERVATION YELLOW~~
CORPORATE LIMITS (GREEN)

76411 Replace 5-11-51 TCK

OFFICE COPY 1950

MAP OF THE TOWN OF COLLINS
ERIE COUNTY, N.Y.
ERIE COUNTY PLANNING BOARD
1948

SPECIAL ENUMERATION AREAS
15-107 GOWANDA STATE HOMEOPATHIC HOSPITAL

DUPLICATE COPY OF ORIGINAL 1950 OFFICE MAP PREPARED
BY Marsh
VERIFIED TO ORIGINAL 1950 OFFICE MAP & E.D.
DESCRIPTIONS BY Henderson
DATE COPY WAS MADE 7-24-61

NOTE: This map is compiled from deeds recorded in the Erie County Clerk's Office, surveys and other available data.

Correted January 1948

COPYRIGHT 1936, NIAGARA FRONTIER PLANNING BOARD

76419

1950 OFFICE MAP

OFFICE COPY 1950

MAP OF
THE TOWN OF
CONCORD
ERIE COUNTY, N.Y.

Compiled by
ERIE COUNTY PLANNING BOARD
194

Note. This map is compiled from deeds recorded in the Erie County Clerk's Office. Lots in the Village of Springville are not shown and Town lots of less than one acre are not shown.

••LEGEND••

- County Line
- Township & Range Line
- Power Line
- City & Village Line
- Farm or Great Lot Line
- Property Line
- State Highway (S H)
- County Highway (C H)
- Town Highway (T H)
- Railroads
- Streams
- Parks

76417

SCALE

Feet

0 1000 2000 3000 4000 5000

Miles

LEGEND
Town Line ---------- Red
Village Limits ----------- Green

• THE NIAGARA FRONTIER •

CORRECTED TO JAN. 1, 1948

18

76417

ENTIRELY WITHIN BUFFALO URBANIZED AREA

OFFICE COPY 1950

1950 OFFICE MAP

VILLAGE OF DEPEW, NY

AREA: 5.37 SQ. MILES.

73740

NEW YORK

Erie 30-15

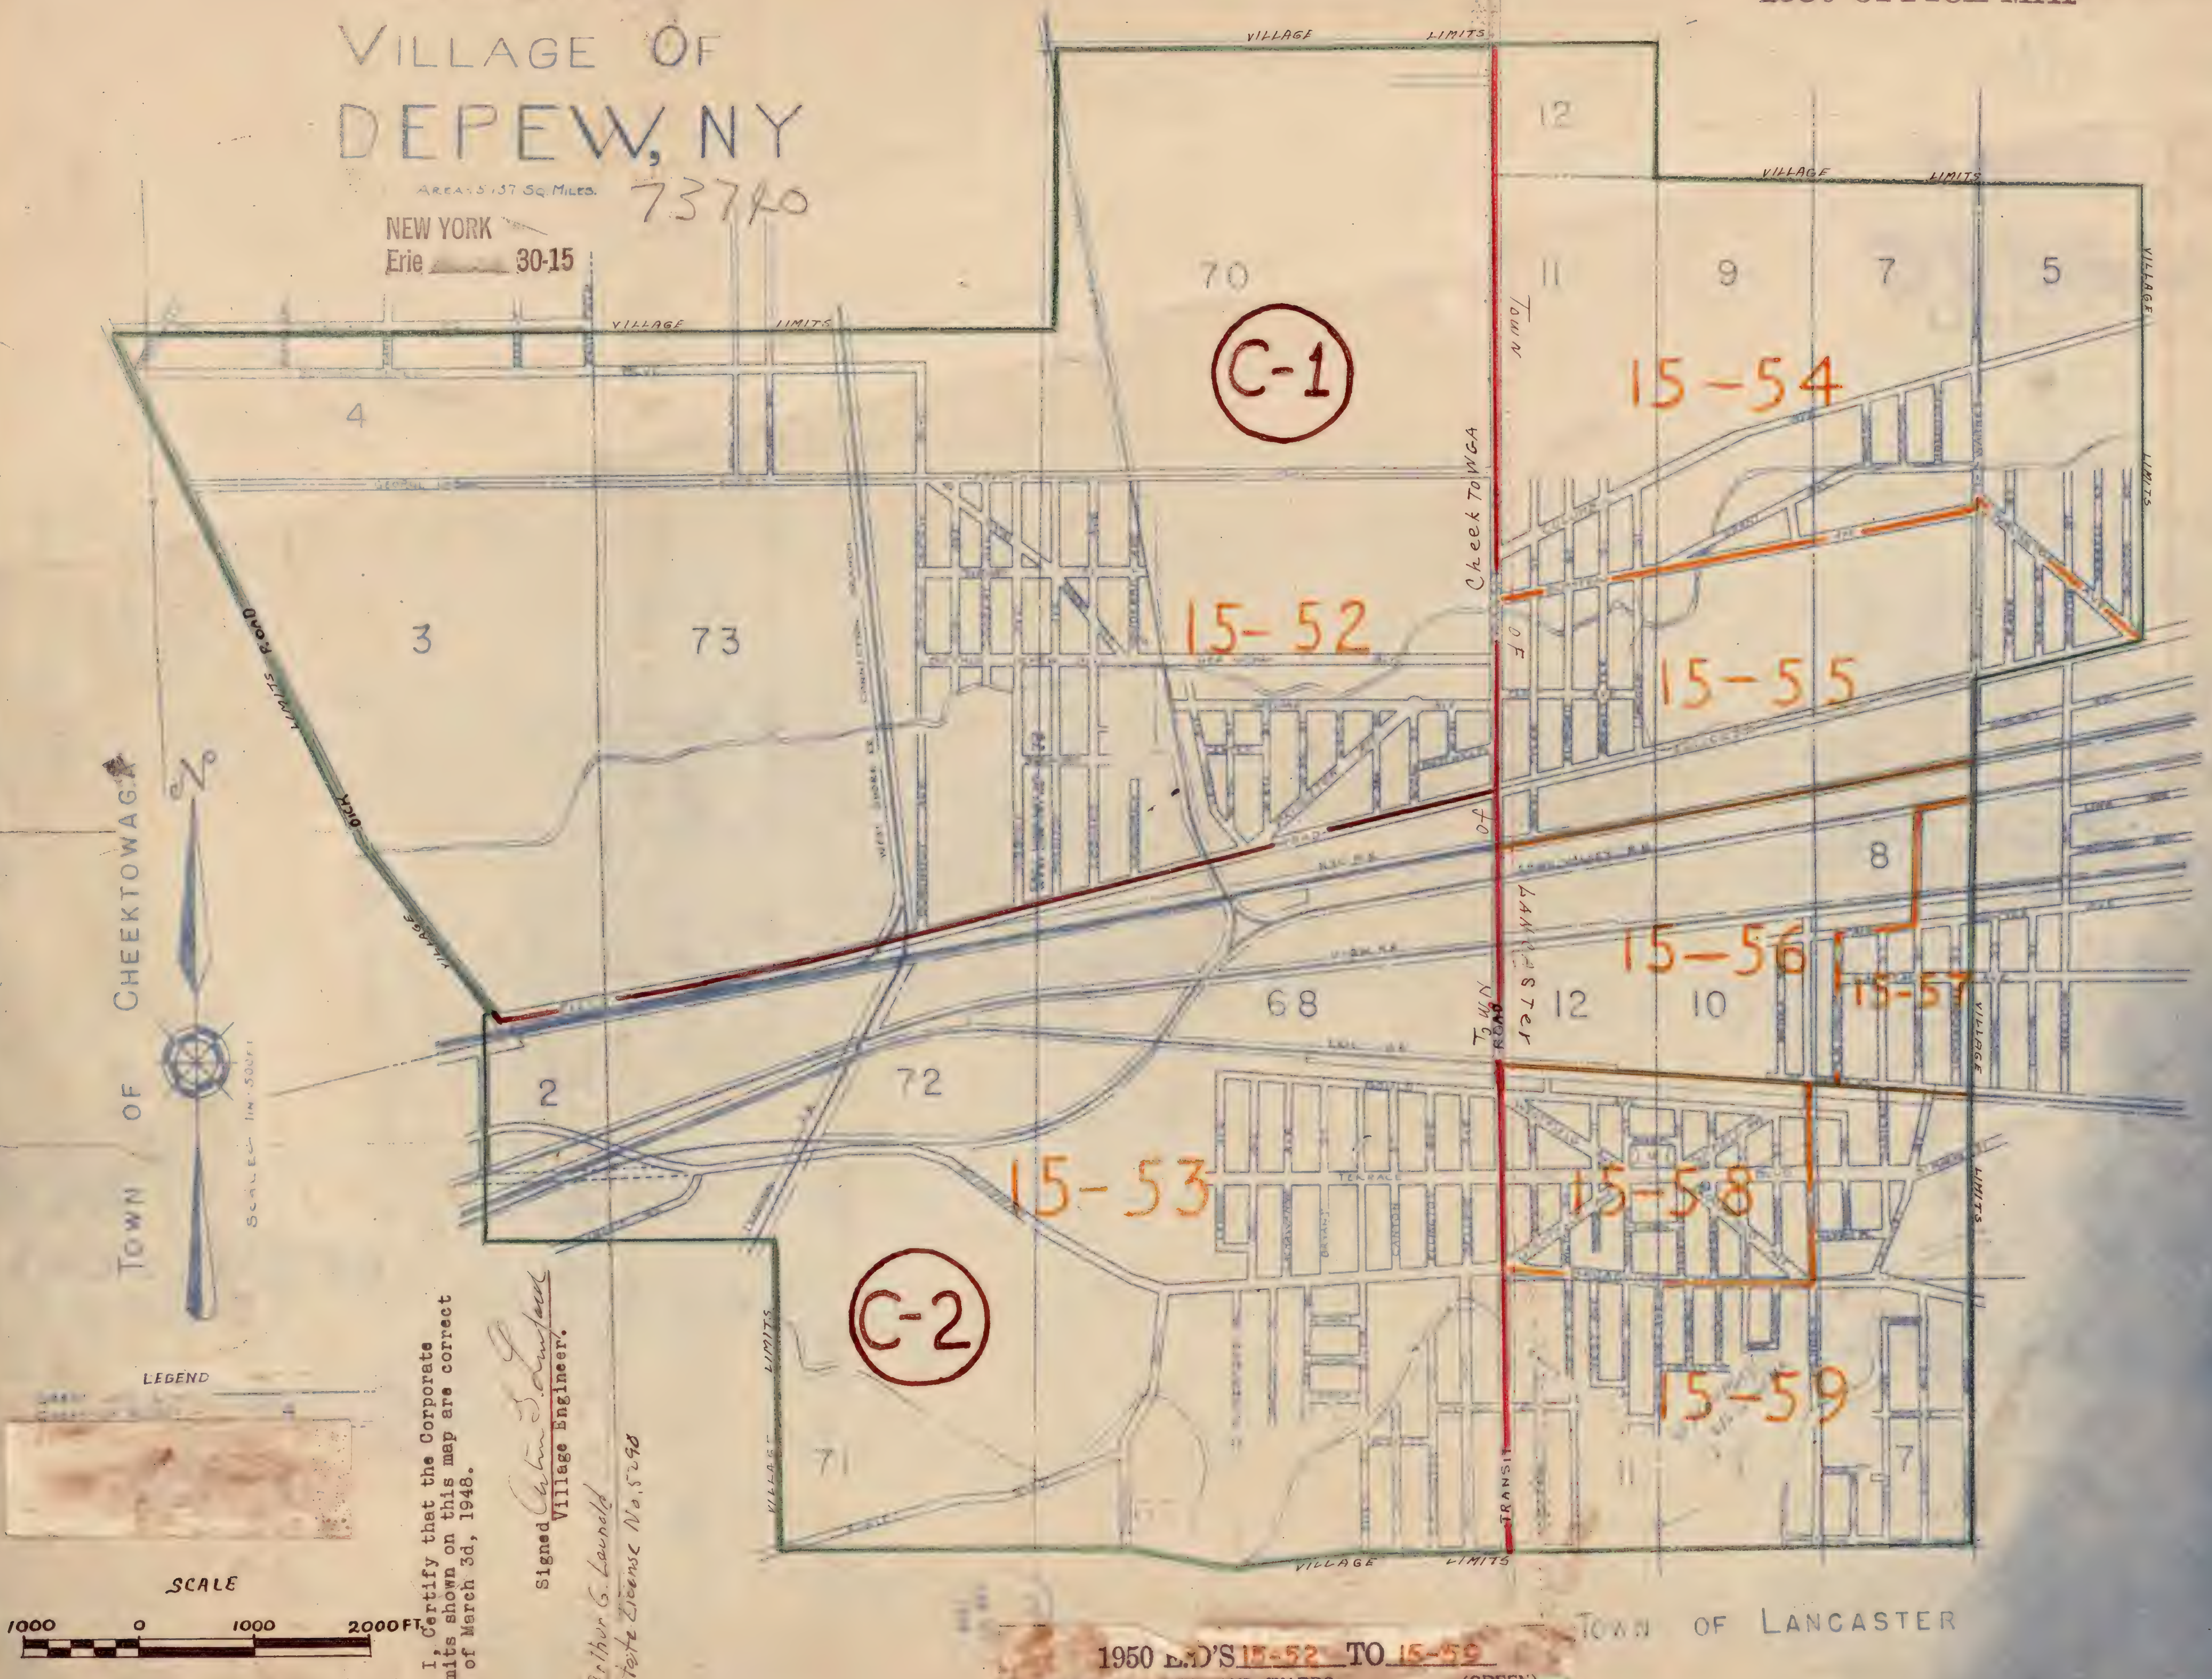

I, Certify that the Corporate limits shown on this map are correct as of March 3d, 1948.

Signed Calvin S. Lunford
Village Engineer.

Arthur G. Launold
State License No. 5298

1950 E.D'S 15-52 TO 15-59
CORPORATE LIMITS AND WARDS (GREEN)
ENUMERATION DISTRICT (ORANGE)
CENSUS TRACT ⓒ (BROWN)
TOWN LINE (RED)

73740

1950 OFFICE MAP

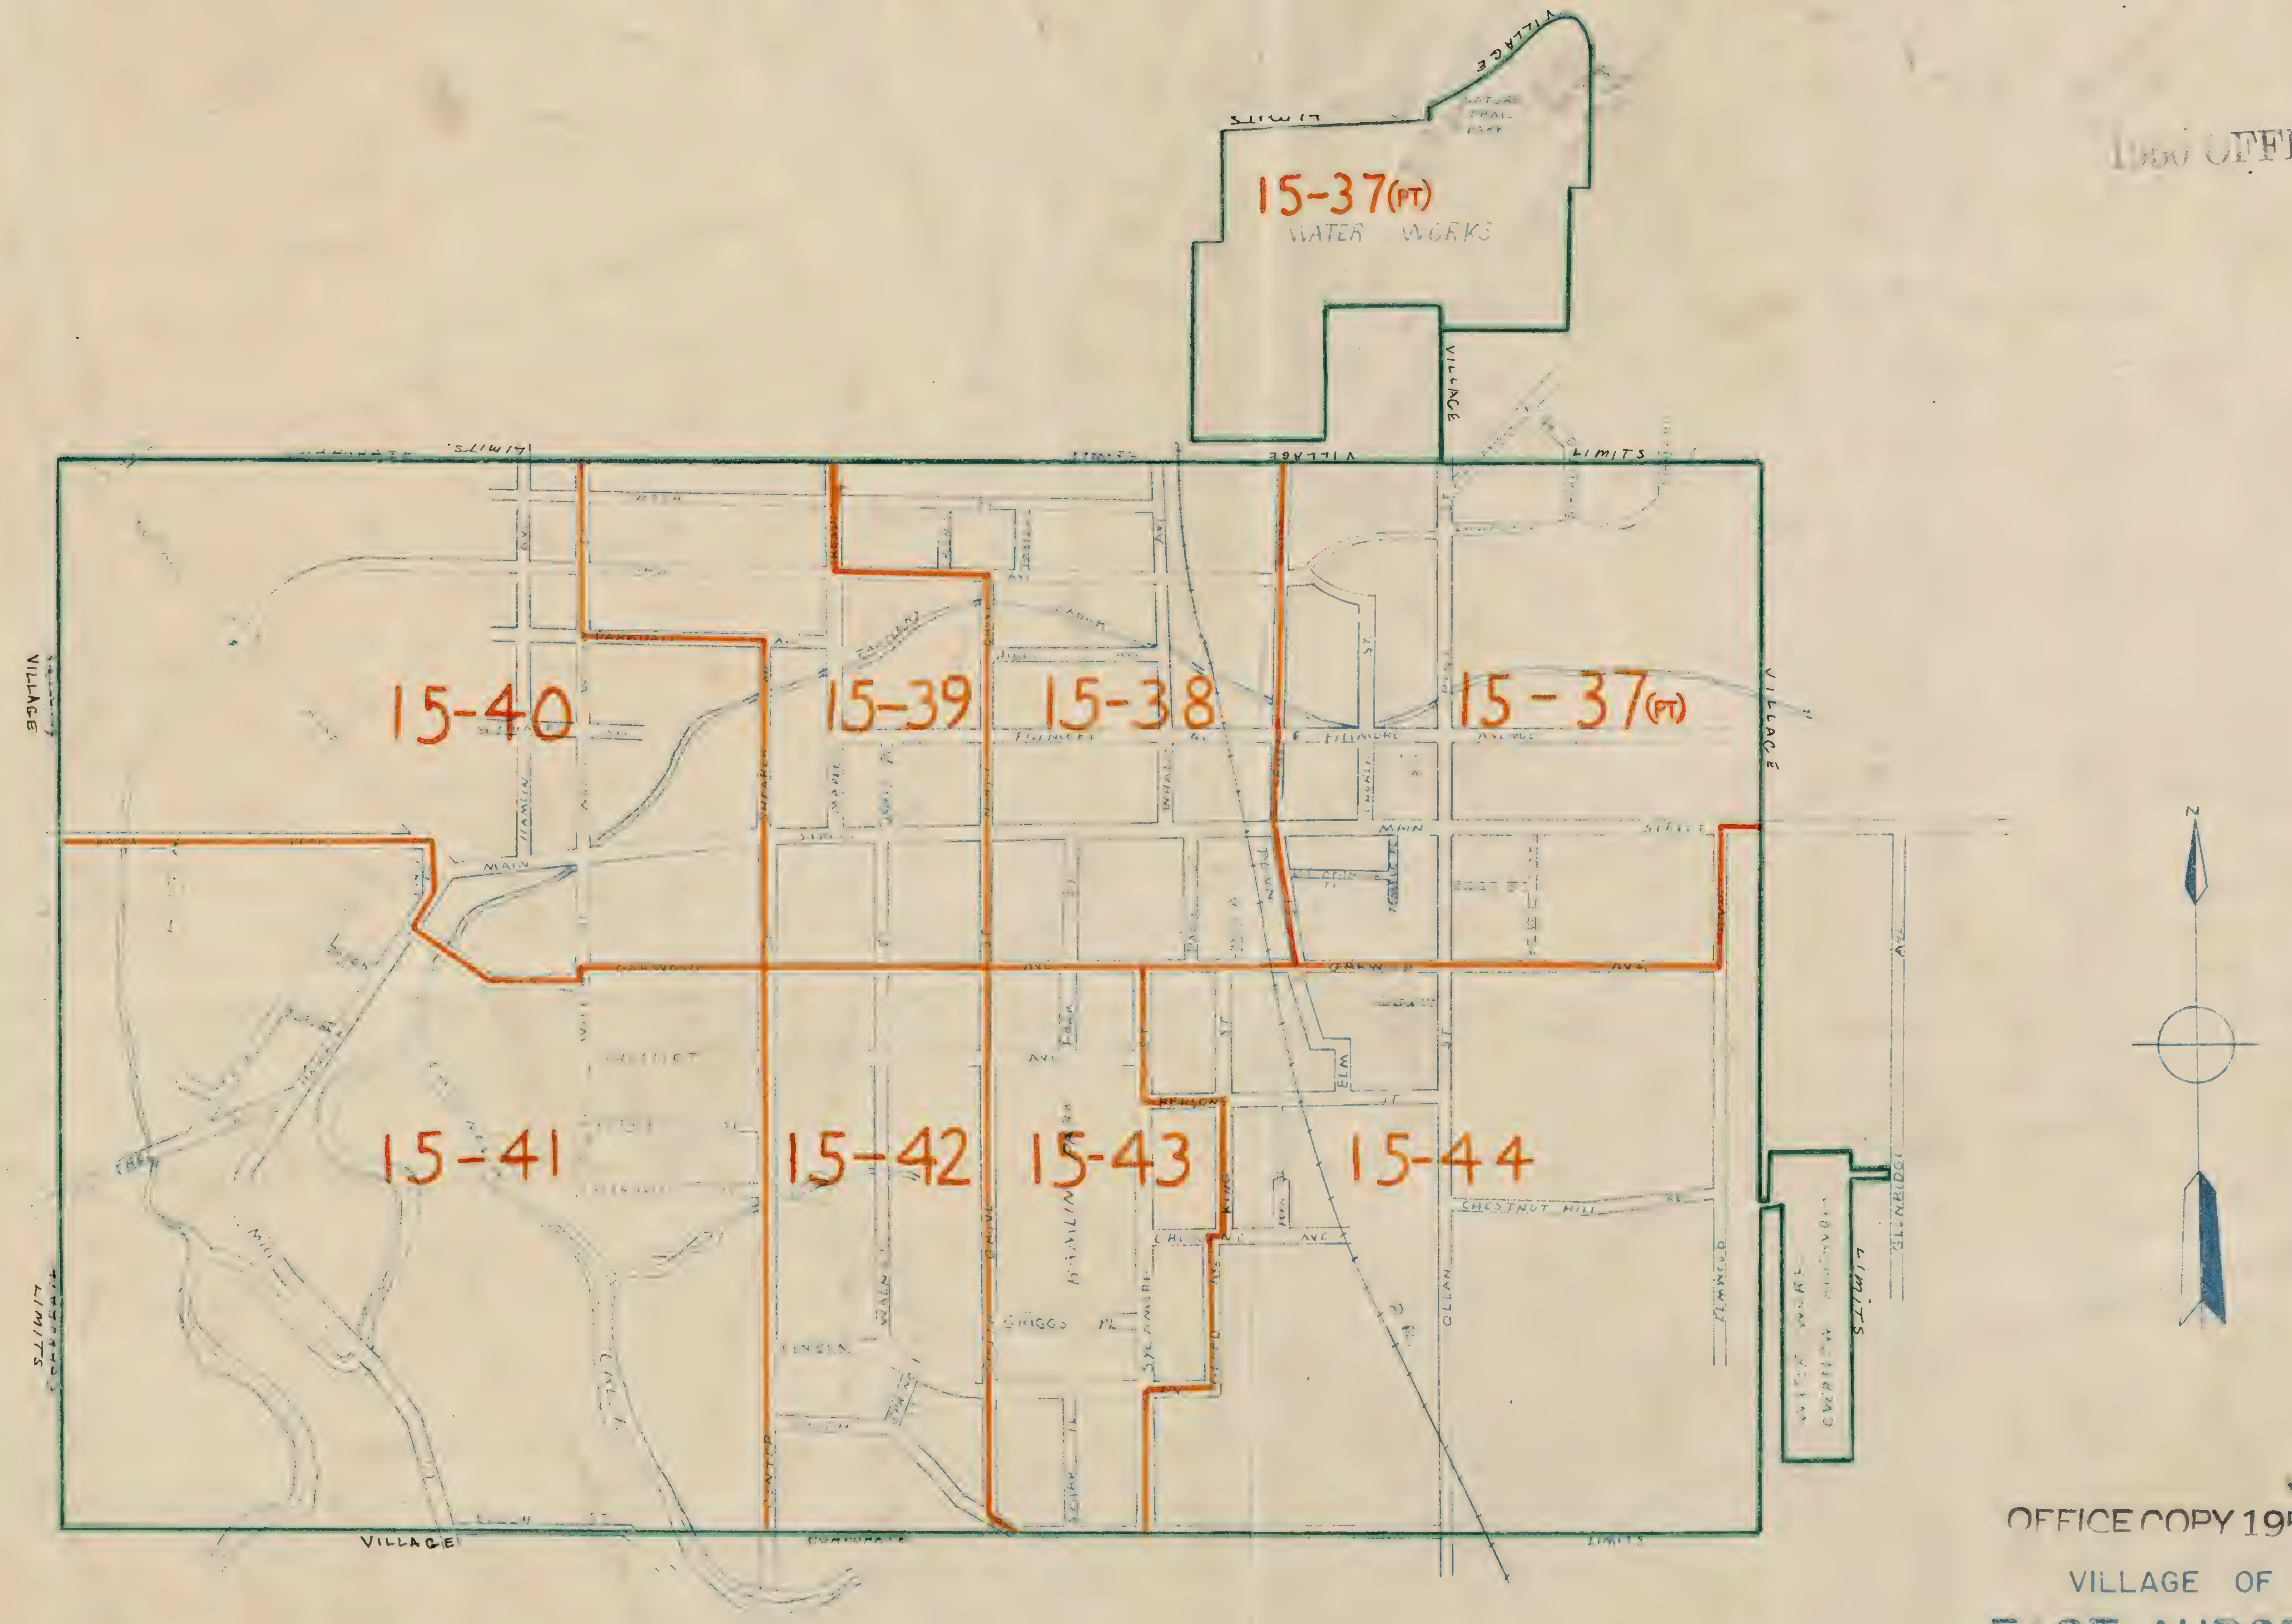

OFFICE COPY 1950

VILLAGE OF

EAST AURORA

ERIE CO. N.Y.

SCALE

700 0 700 1400 FT

COMPILED FROM MAP FILE NO.73700

———— · ———— · CORPORATE LIMITS

LEGEND

1950 E.D'S 15-37 TO 15

CORPORATE LIMITS ~~AND WARDS~~ ____ EN)

ENUMERATION DISTRICT ____ (ORANGE)

COMPILED BY R.E.MOORE 8-18-48

BUREAU OF THE CENSUS

92089

1950 OFFICE MAP

SEE DETAILED MAPS FOR:

AKRON VILLAGE
ALDEN VILLAGE
ALDEN TOWN
AMHERST TOWN
ANGOLA VILLAGE
ANGOLA-ON-THE-LAKE (UNINC)
AURORA TOWN
BELLEVUE-HOMEWOOD PARK (UNINC)
BLASDELL VILLAGE
BOSTON TOWN
BRANT TOWN
CHEEKTOWAGA TOWN
CLARENCE (UNINC)
CLARENCE CENTER (UNINC)
CLARENCE TOWN
COLDEN TOWN
COLLINS (UNINC)
COLLINS TOWN
CONCORD TOWN
DEPEW VILLAGE
EAST AURORA VILLAGE
EDEN (UNINC)
EDEN TOWN
ELMA TOWN
EVANS TOWN
FARNHAM VILLAGE
GRAND ISLAND TOWN
GOWANDA VILLAGE
HAMBURG VILLAGE
HAMBURG TOWN
HIGHLAND-ON-THE-LAKE (UNINC)
HOLLAND (UNINC)
HOLLAND TOWN
KENMORE VILLAGE
LACKAWANNA CITY
LAKE ERIE BEACH (UNINC)
LANCASTER VILLAGE
LANCASTER TOWN
MARILLA TOWN
NEWSTEAD TOWN
NORTH COLLINS VILLAGE
NORTH COLLINS TOWN
ORCHARD PARK VILLAGE
ORCHARD PARK TOWN
SANDY BEACH (UNINC)
SARDINIA TOWN
SLOAN VILLAGE
SPRINGVILLE VILLAGE
TONAWANDA CITY
TONAWANDA TOWN
WALES TOWN
WEST SENECA TOWN
WILLIAMSVILLE VILLAGE

SPECIAL ENUMERATION AREAS

15-334 THOMAS INDIAN SCHOOL (IN CATTARAUGUS INDIAN RESERVATION)

1950 E.D'S 15-1 TO 15-337 AND 65-1 TO 65-880

COUNTY AND MCD (TOWN)	(RED)
INCORPORATED PLACE	(GREEN)
ENUMERATION DISTRICT	(ORANGE)
CONGRESSIONAL DISTRICT	(BLUE)

ERIE COUNTY
NEW YORK

PREPARED BY THE
N.Y. STATE DEPARTMENT OF PUBLIC WORKS
DIVISION OF HIGHWAYS
IN COOPERATION WITH THE
U.S. FEDERAL WORKS AGENCY
PUBLIC ROADS ADMINISTRATION
DATA OBTAINED FROM
STATEWIDE HIGHWAY PLANNING SURVEY

SCALE
1 0 1 2 MILES

1946
POLYCONIC PROJECTION

DUPLICATE COPY OF ORIGINAL 1950 OFFICE MAP
VERIFIED TO ORIGINAL 1950 OFFICE MAP &
DATE COPY WAS MADE 5-17-61

PREPARED BY C. O. Bailey
DESCRIPTIONS BY

LEGEND SHOWN ON SHEET 2
ENLARGEMENTS SHOWN ON SUPPLEMENTAL SHEET A

SHEET 1 OF 3 MAP SHEETS AND 2 SUPPLEMENTAL SHEETS

ERIE CO (1)

1950 OFFICE MAP

Duplicate copy of original 1950 office map prepared by C.B. [illegible]
Verified to original 1950 office map and E.D. descriptions by Henderson
Date copy was made 5-18-51

STATE KEY MAP SHOWN ON SHEET 1
LEGEND SHOWN ON SHEET 2
SHEET ENLARGEMENTS SHOWN ON SUPPLEMENTAL SHEET B
COMPACT ENLARGEMENTS SHOWN ON SUPPLEMENTAL SHEET B

SHEET 3 OF 3 MAP SHEETS AND 2 SUPPLEMENTAL SHEETS

ERIE co (2)

1950 OFFICE MAP

ERIE COUNTY
NEW YORK

SCALE

1946

DUPLICATE COPY OF ORIGINAL 1950 OFFICE MAP PREPARED BY C. B. Sibley
VERIFIED TO ORIGINAL 1950 OFFICE MAP & E.D. DESCRIPTIONS. BY Haralson
DATE COPY WAS MADE 5-18-51

STATE KEY MAP SHOWN ON SHEET 1
LEGEND SHOWN ON SHEET 2
ENLARGEMENTS SHOWN ON SUPPLEMENTAL SHEET A

SHEET 2 OF 3 MAP SHEETS AND 2 SUPPLEMENTAL SHEETS

1950 OFFICE MAP

MAP OF
THE TOWN OF
EVANS
ERIE COUNTY, N.Y.

Compiled by
ERIE COUNTY PLANNING BOARD
1948

76427

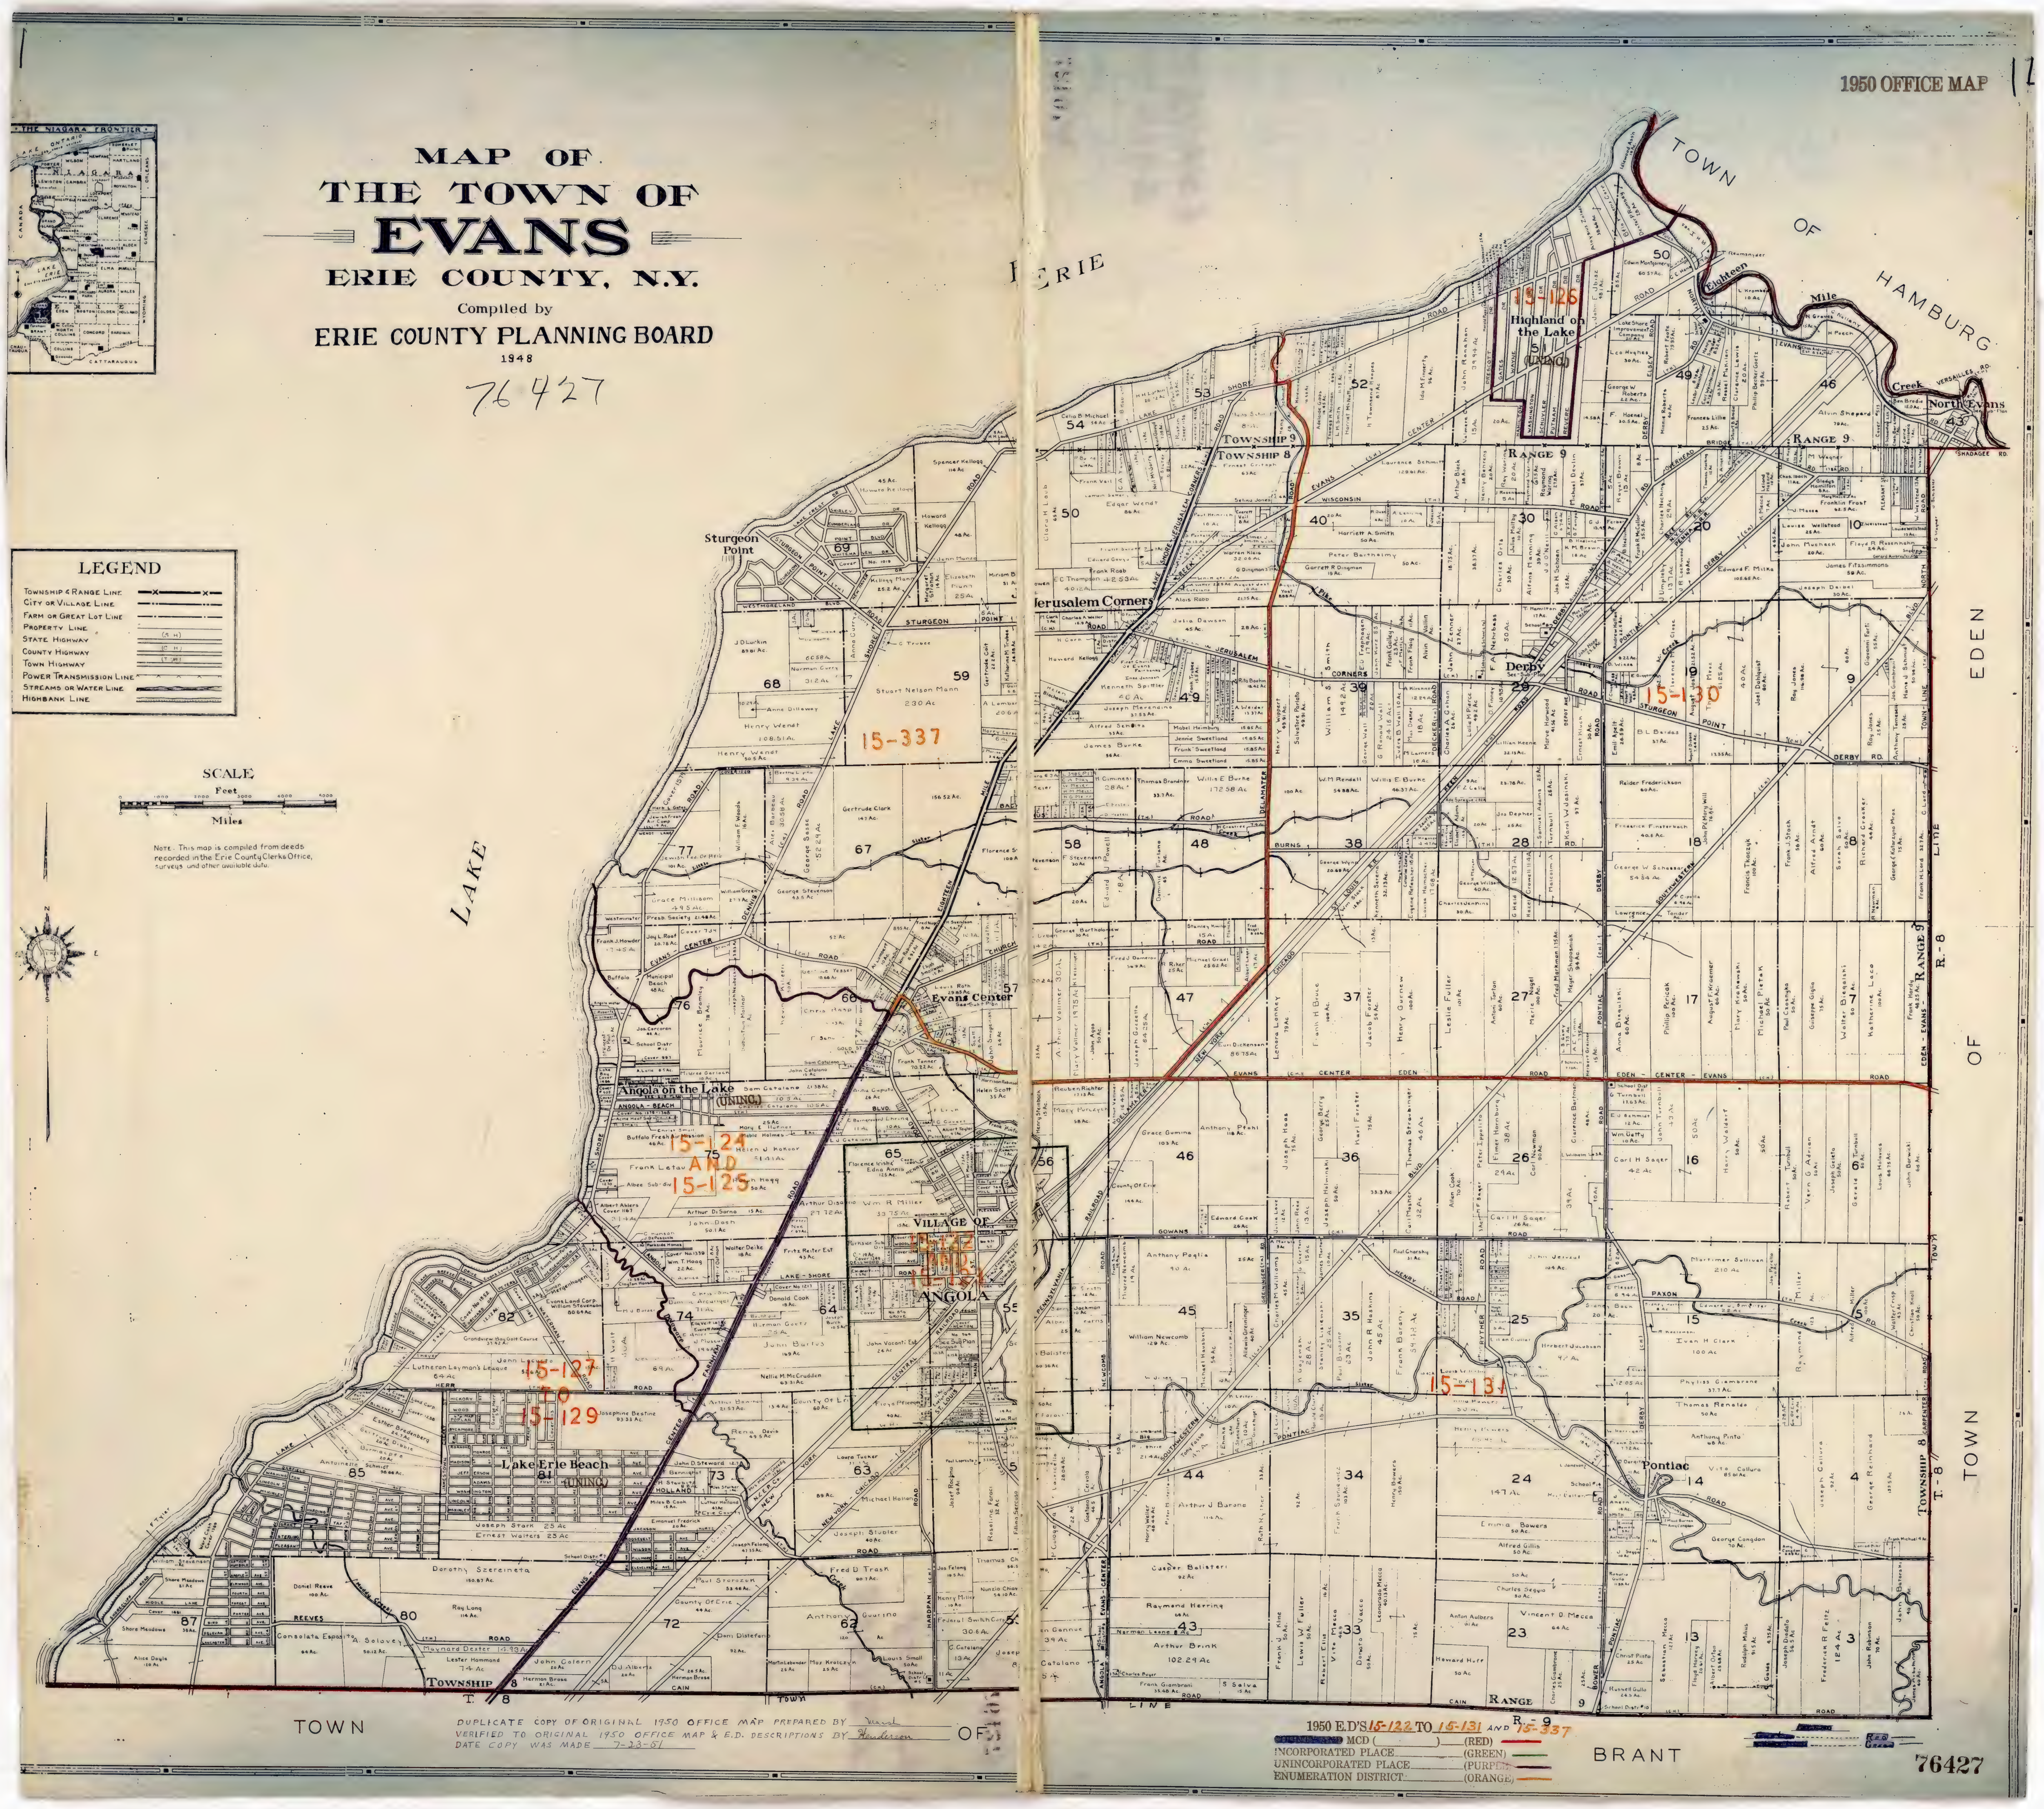

LEGEND

Township & Range Line	—×——×—
City or Village Line	—··——··—
Farm or Great Lot Line	—·——·—
Property Line	——
State Highway	(S H)
County Highway	(C H)
Town Highway	(T H)
Power Transmission Line	×—×—×—×
Streams or Water Line	≈≈
Highbank Line	⧺

SCALE
Feet
0 1000 2000 3000 4000 5000
0 ⅛ ¼ ½ ¾
Miles

Note. This map is compiled from deeds recorded in the Erie County Clerks Office, surveys and other available data.

DUPLICATE COPY OF ORIGINAL 1950 OFFICE MAP PREPARED BY Marsh
VERIFIED TO ORIGINAL 1950 OFFICE MAP & E.D. DESCRIPTIONS BY Henderson
DATE COPY WAS MADE 7-23-51

1950 E.D'S 15-122 TO 15-131 AND 15-337
[redacted] MCD (______)____(RED)
INCORPORATED PLACE______(GREEN)
UNINCORPORATED PLACE______(PURPLE)
ENUMERATION DISTRICT______(ORANGE)

76427

1940 OFFICE MAP

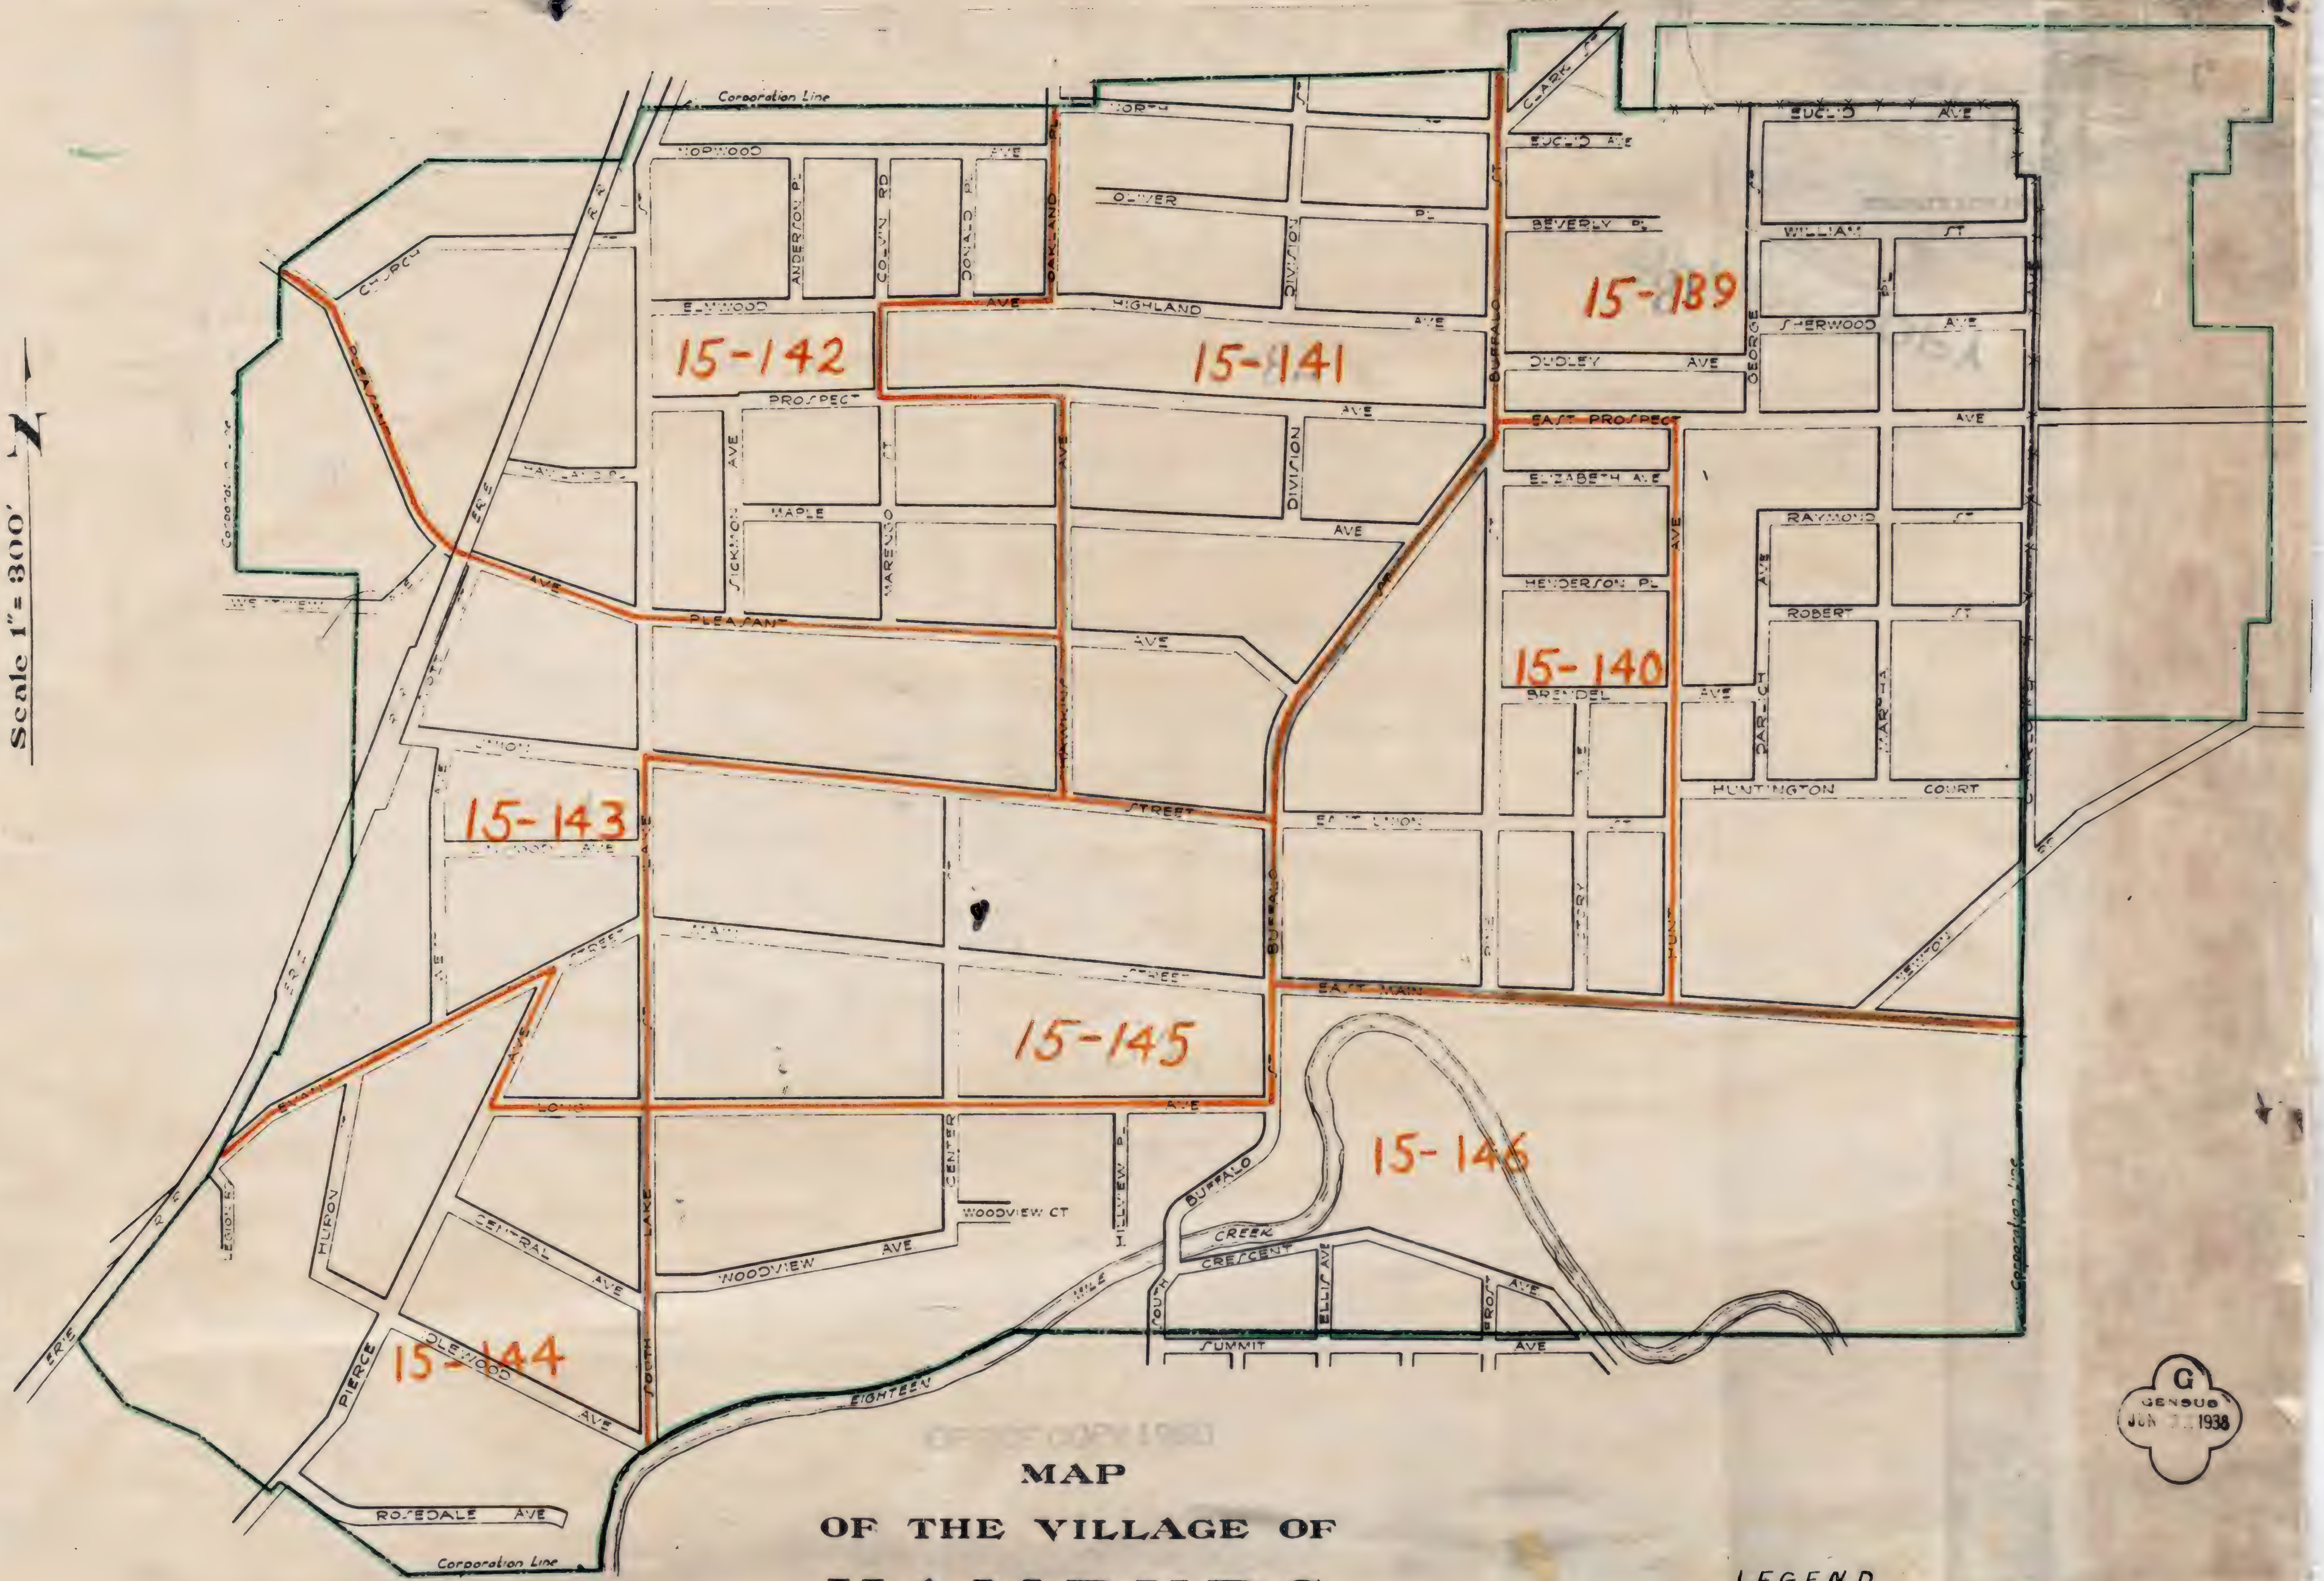

MAP
OF THE VILLAGE OF
HAMBURG
EDs 15-81 TO 15-85
ERIE COUNTY, NEW YORK.

0 500 1000 Feet

LEGEND
Village Limits Green
E.D. Orange

LEGEND
Village Limits - Green

G
CENSUS
JUN 2 1938

PARTLY WITHIN BUFFALO URBANIZED AREA

1950 OFFICE MAP

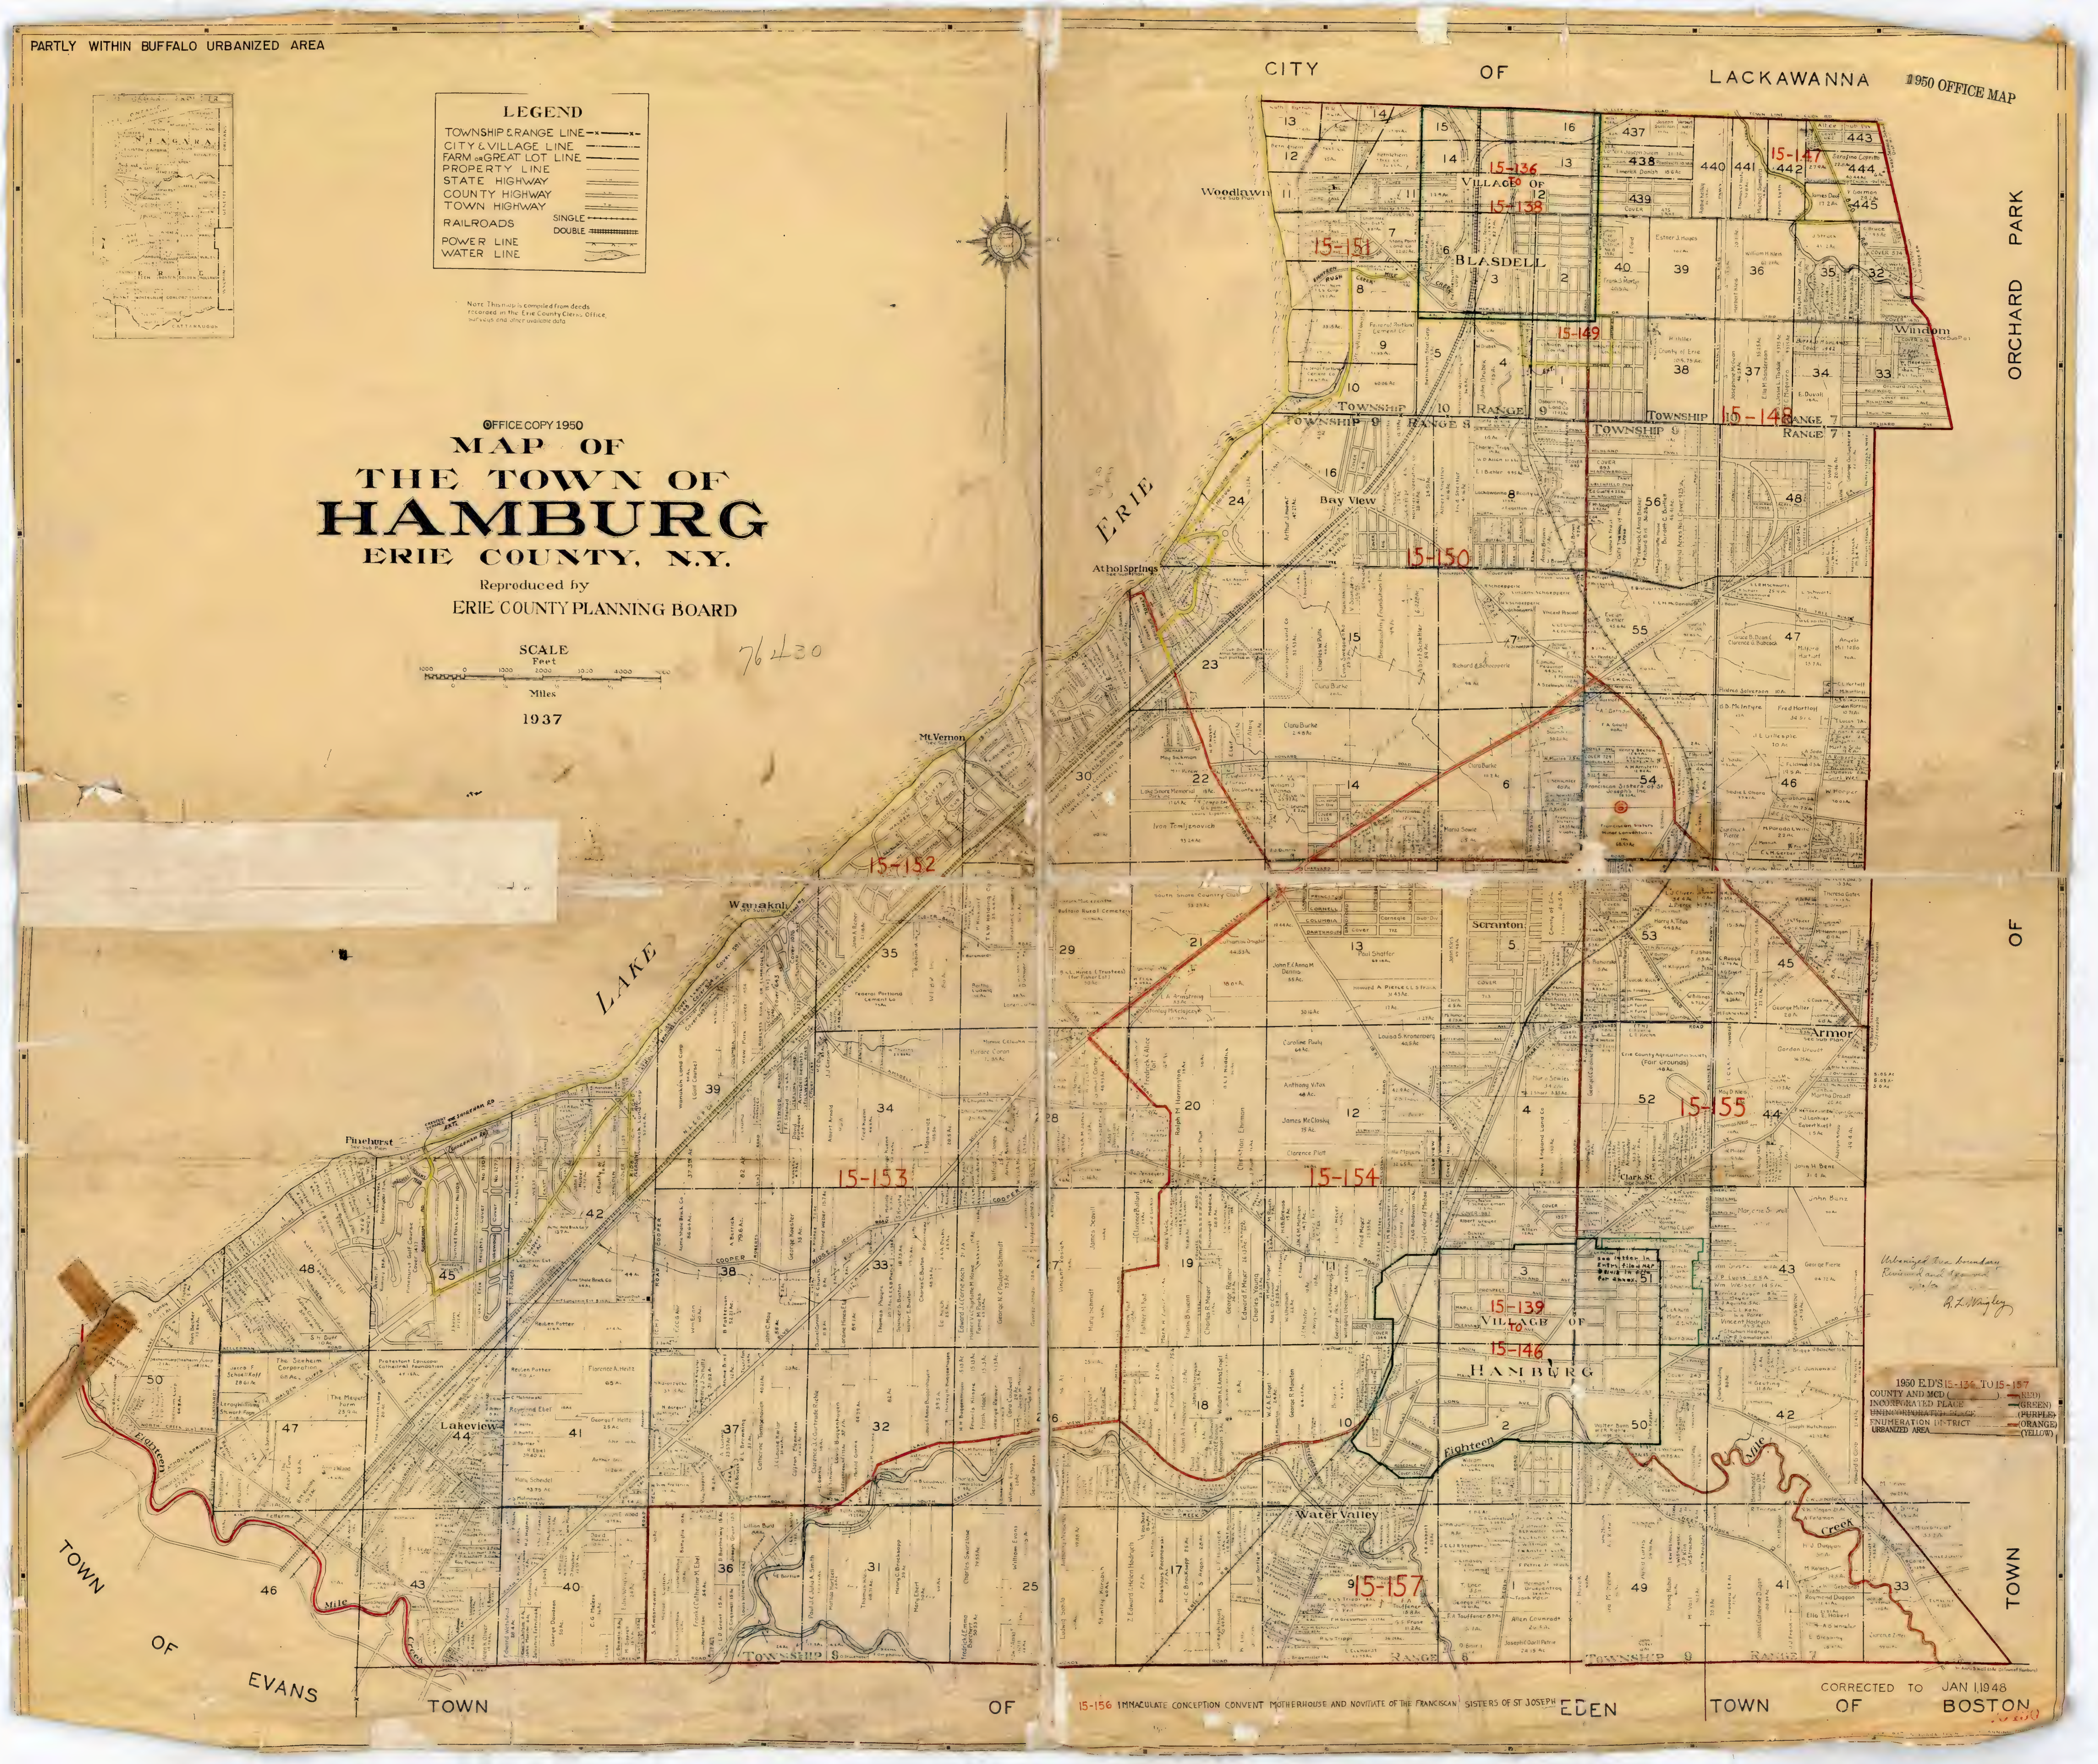

OFFICE COPY 1950

MAP OF THE TOWN OF HAMBURG ERIE COUNTY, N.Y.

Reproduced by
ERIE COUNTY PLANNING BOARD

SCALE
Feet
Miles

1937

76430

LEGEND
- TOWNSHIP & RANGE LINE
- CITY & VILLAGE LINE
- FARM OR GREAT LOT LINE
- PROPERTY LINE
- STATE HIGHWAY
- COUNTY HIGHWAY
- TOWN HIGHWAY
- RAILROADS SINGLE
- RAILROADS DOUBLE
- POWER LINE
- WATER LINE

Note This map is compiled from deeds recorded in the Erie County Clerks Office, surveys and other available data

1950 E.D'S 15-136 TO 15-157
- COUNTY AND MCD (______)——(RED)
- INCORPORATED PLACE ——(GREEN)
- ~~UNINCORPORATED PLACE~~ ——(PURPLE)
- ENUMERATION DISTRICT ——(ORANGE)
- URBANIZED AREA ——(YELLOW)

Urbanized Area boundary
Reviewed and approved
6/30/50
R. L. Wrigley

15-156 IMMACULATE CONCEPTION CONVENT MOTHERHOUSE AND NOVITIATE OF THE FRANCISCAN SISTERS OF ST JOSEPH

CORRECTED TO JAN 1, 1948

ENTIRELY WITHIN BUFFALO URBANIZED AREA

1950 OFFICE MAP

OFFICE COPY 1950

ERIE COUNTY

VILLAGE OF KENMORE
New York

NEW YORK
Erie 30-15

I certify that the corporate limits shown on this map are correct as of March 31st, 1948.

Village Clerk
March 30 1948

E.D'S 15-255 TO 15-280
LIMITS (GREEN)
N DISTRICT (ORANGE)
T K-2 (BROWN)

74204

ENTIRELY WITHIN BUFFALO URBANIZED AREA

1950 OFFICE MAP

CITY OF LACKAWANNA

ERIE Co., N.Y.

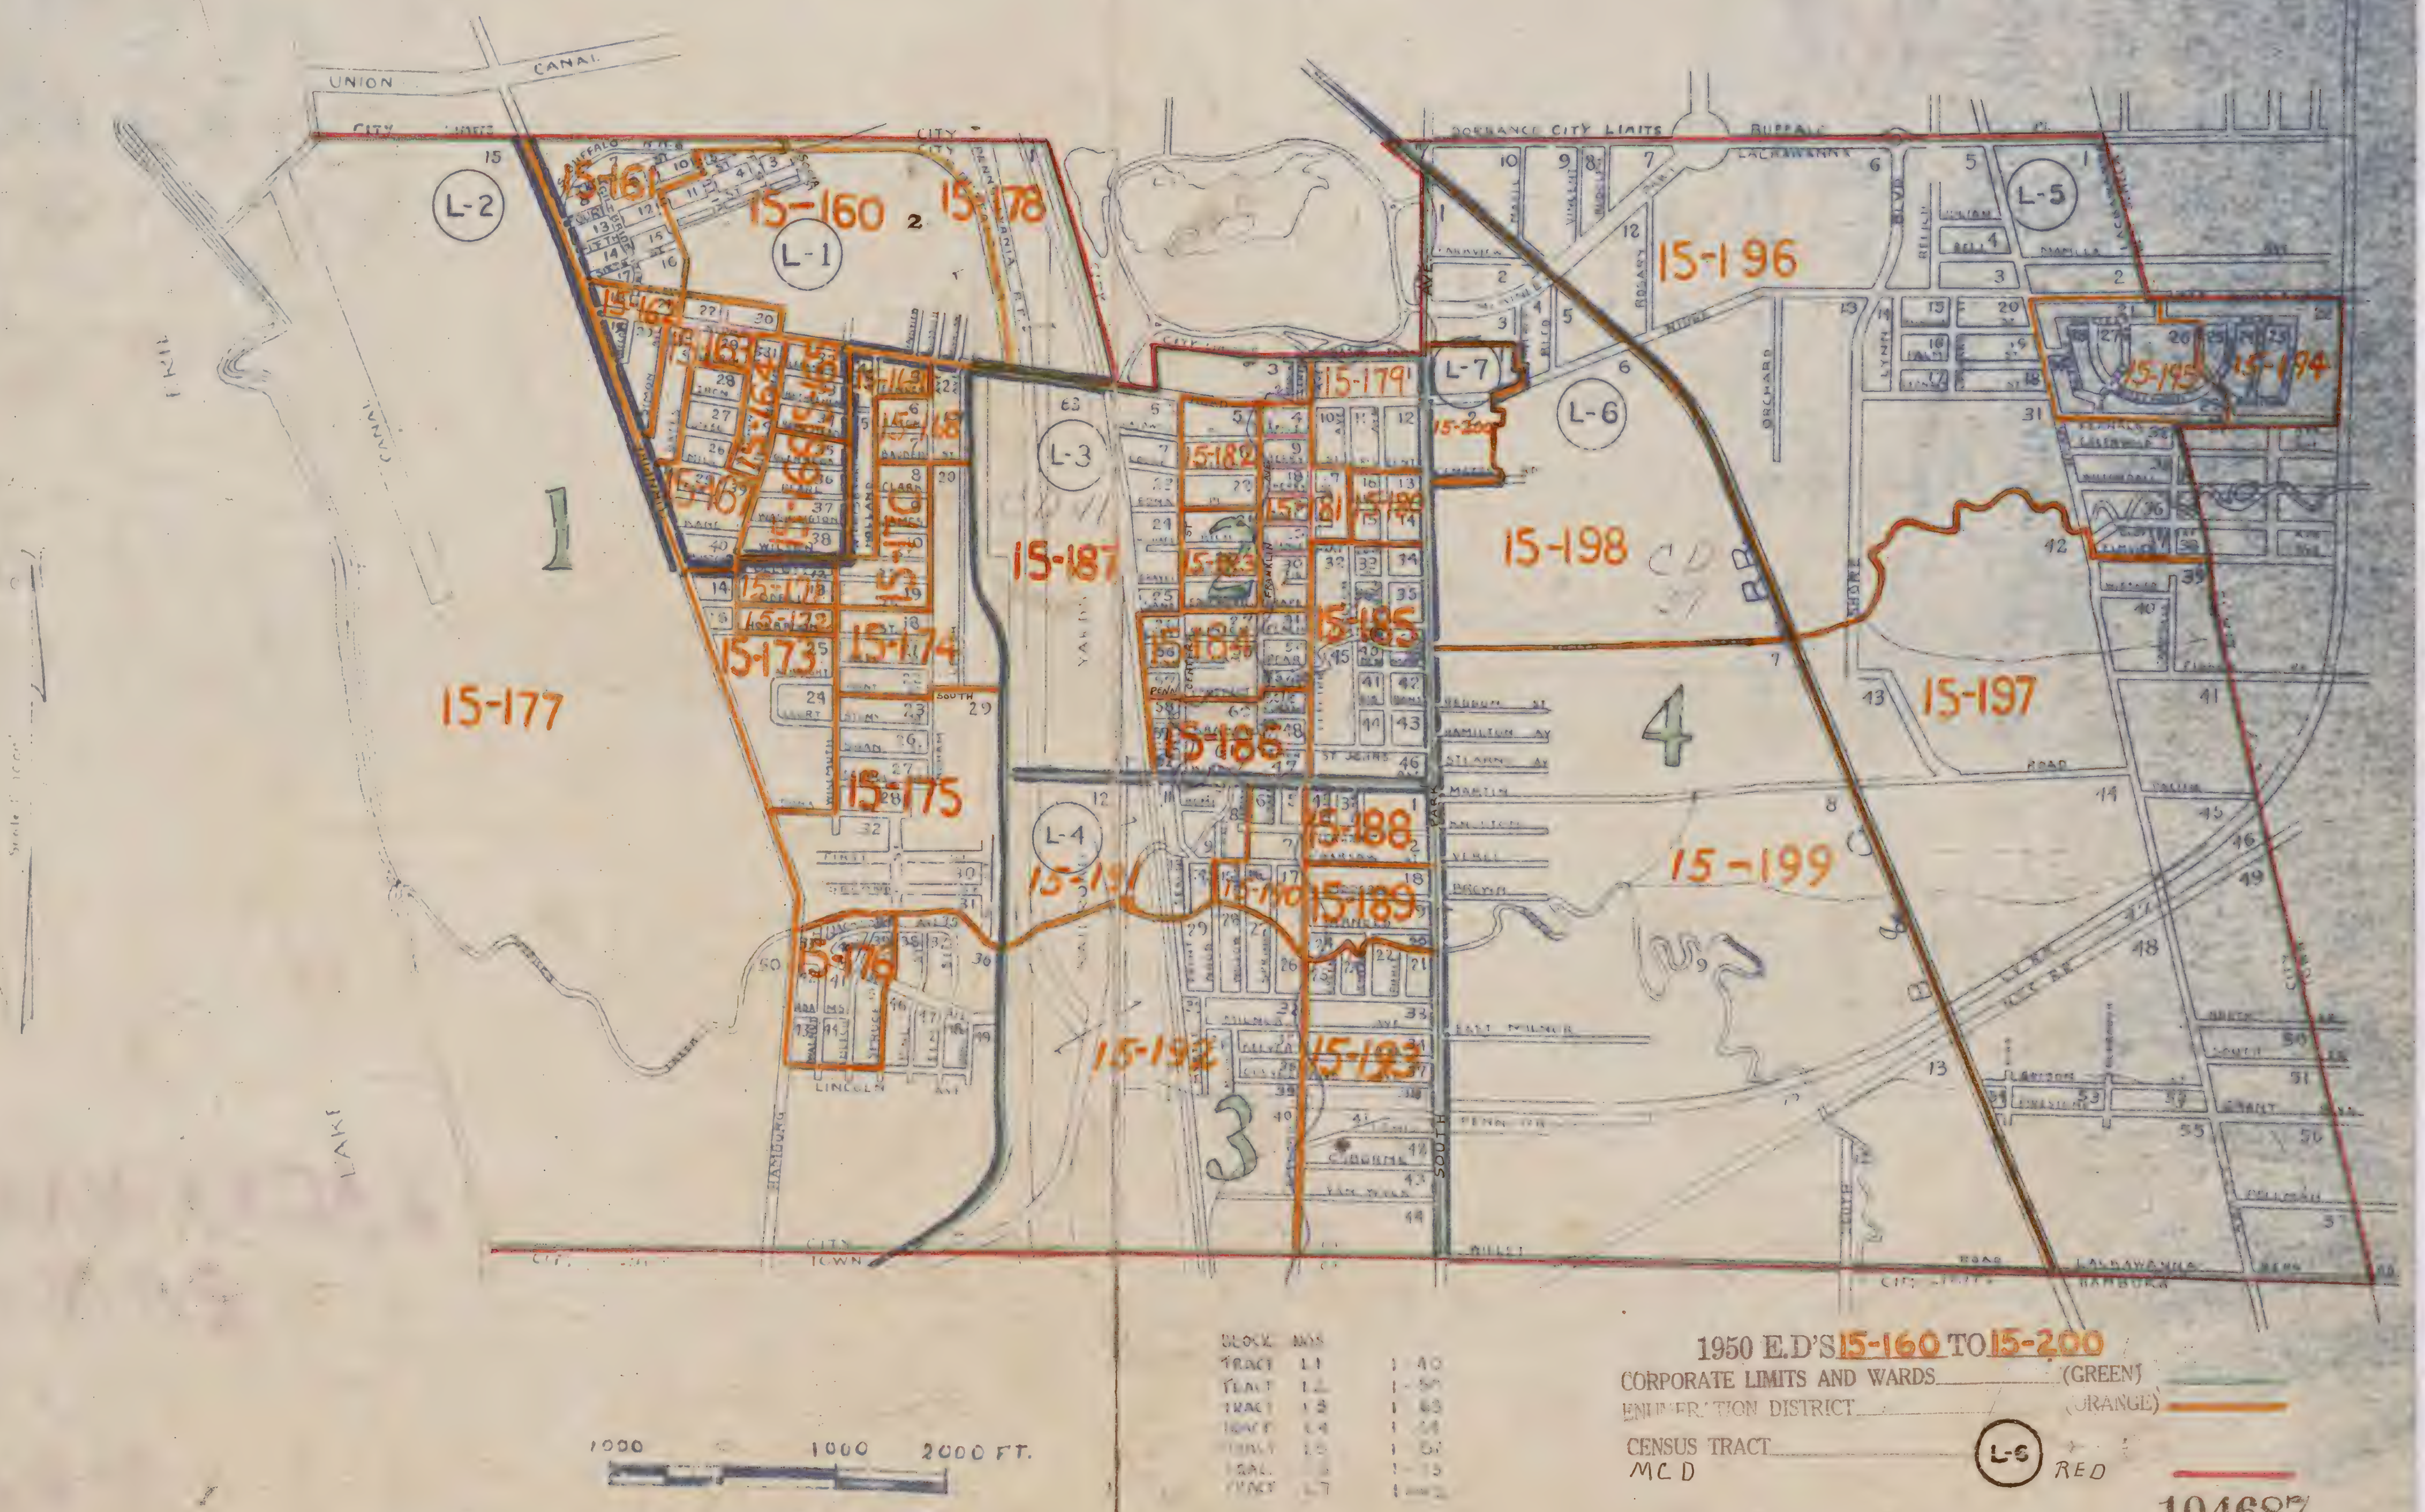

BLOCK NOS	
TRACT L1	1-40
TRACT L2	1-50
TRACT L3	1-63
TRACT L4	1-44
TRACT L5	1-57
TRACT L6	1-15
TRACT L7	[illegible]

1950 E.D'S 15-160 TO 15-200

CORPORATE LIMITS AND WARDS (GREEN)

ENUMERATION DISTRICT (ORANGE)

CENSUS TRACT (L-6)

MCD RED

104687

1950 OFFICE MAP

MAP OF THE TOWN OF LANCASTER

ERIE COUNTY, N.Y.

Compiled by

ERIE COUNTY PLANNING BOARD

77761

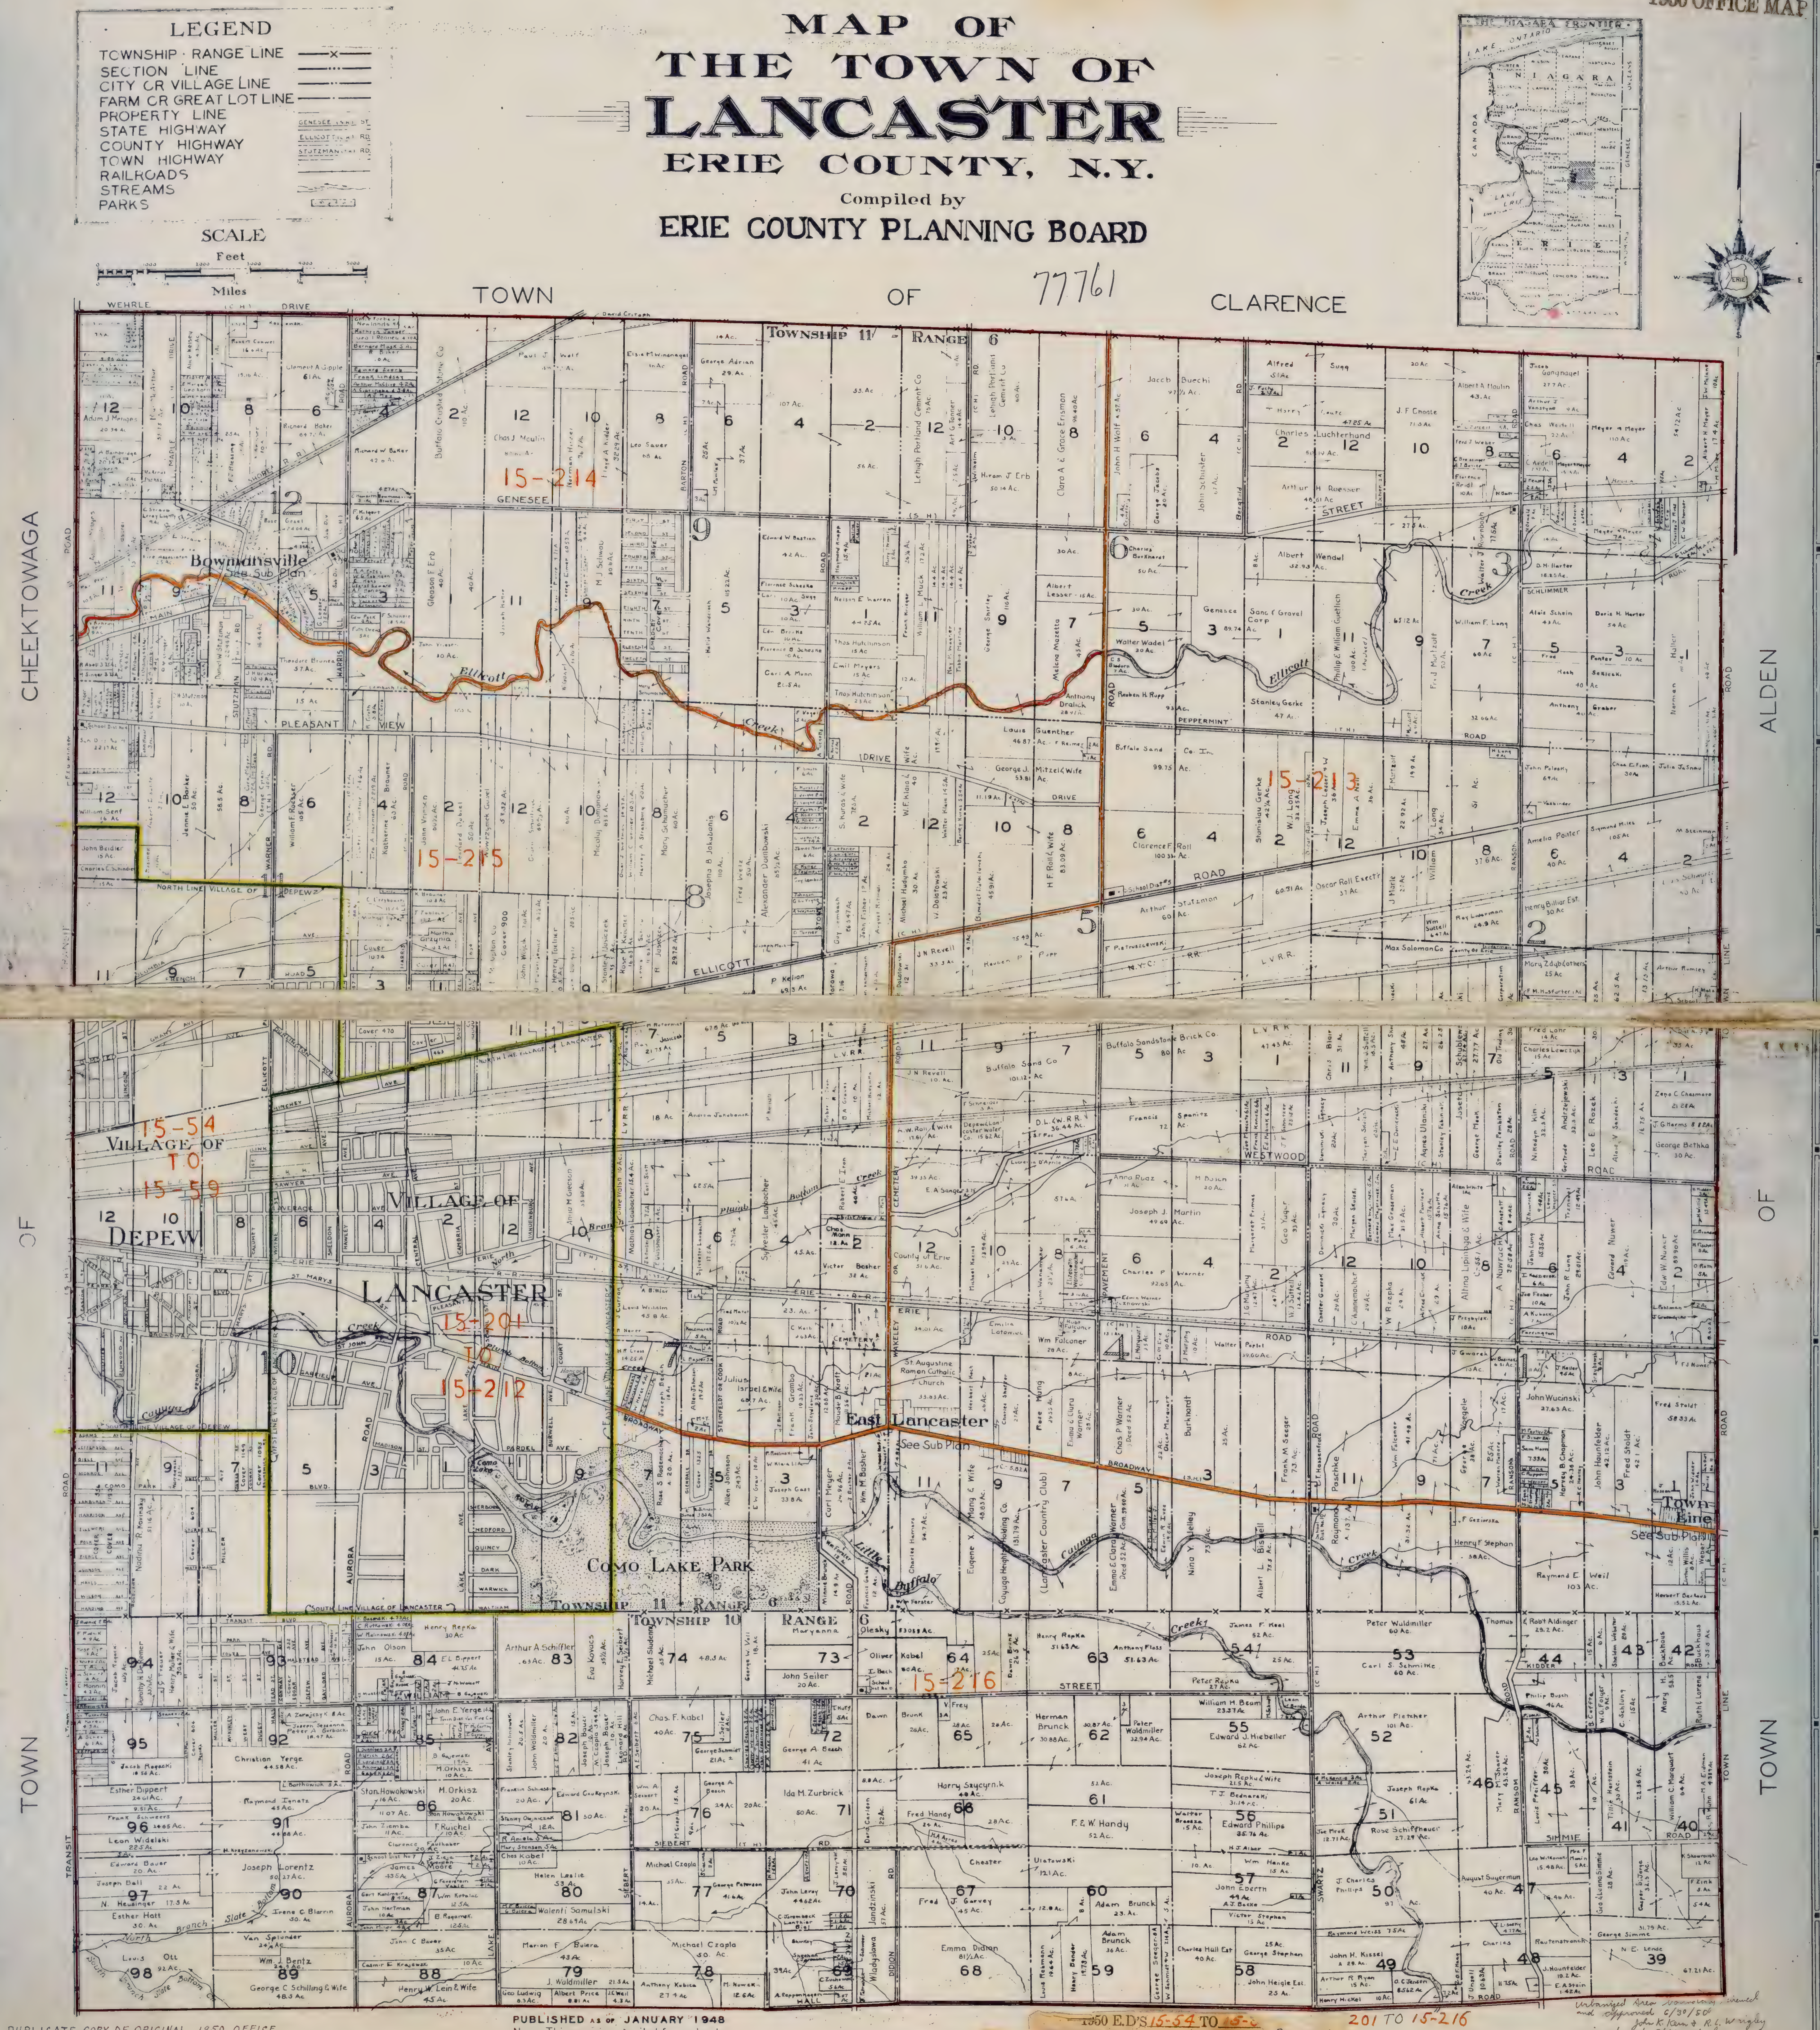

DUPLICATE COPY OF ORIGINAL 1950 OFFICE MAP PREPARED BY Ward

VERIFIED TO ORIGINAL 1950 OFFICE MAP & E.D. DESCRIPTIONS BY Henderson

DATE COPY WAS MADE 7-23-51

PUBLISHED AS OF JANUARY 1948

NOTE: This map is compiled from deeds recorded in the Erie County Clerks Office, surveys and other available data.

1950 E.D'S 15-54 TO 15-[illegible] 201 TO 15-216

[redacted] MCD (________)____(RED Red —

INCORPORATED PLACE ____(GREEN Green —

[redacted]

ENUMERATION DISTRICT________(ORANGE

URBANIZED AREA________(YELLOW

Urbanized Area boundary viewed and approved 6/30/50 John K. Kern & R.L. Wrigley reviewed and approved for new copy map 7/2/51. Sam Melter

77761 77761

ENTIRELY WITHIN BUFFALO
URBANIZED AREA

OFFICE COPY 1950

1950 OFFICE MAP

RAILROADS SHOWN

73698

VILLAGE OF
LANCASTER, N.Y.

REVISED TO JAN. 1st, 1948
HAROLD J. HUBER, SUPT. PUBLIC WORKS

NEW YORK
Erie 30-15

SCALE IN FEET

LEGEND

VILLAGE LIMITS - GREEN
WARD LINES - GREEN
ENUMERATION DISTRICT ORANGE
1950 ED'S 15-201 TO 15-212

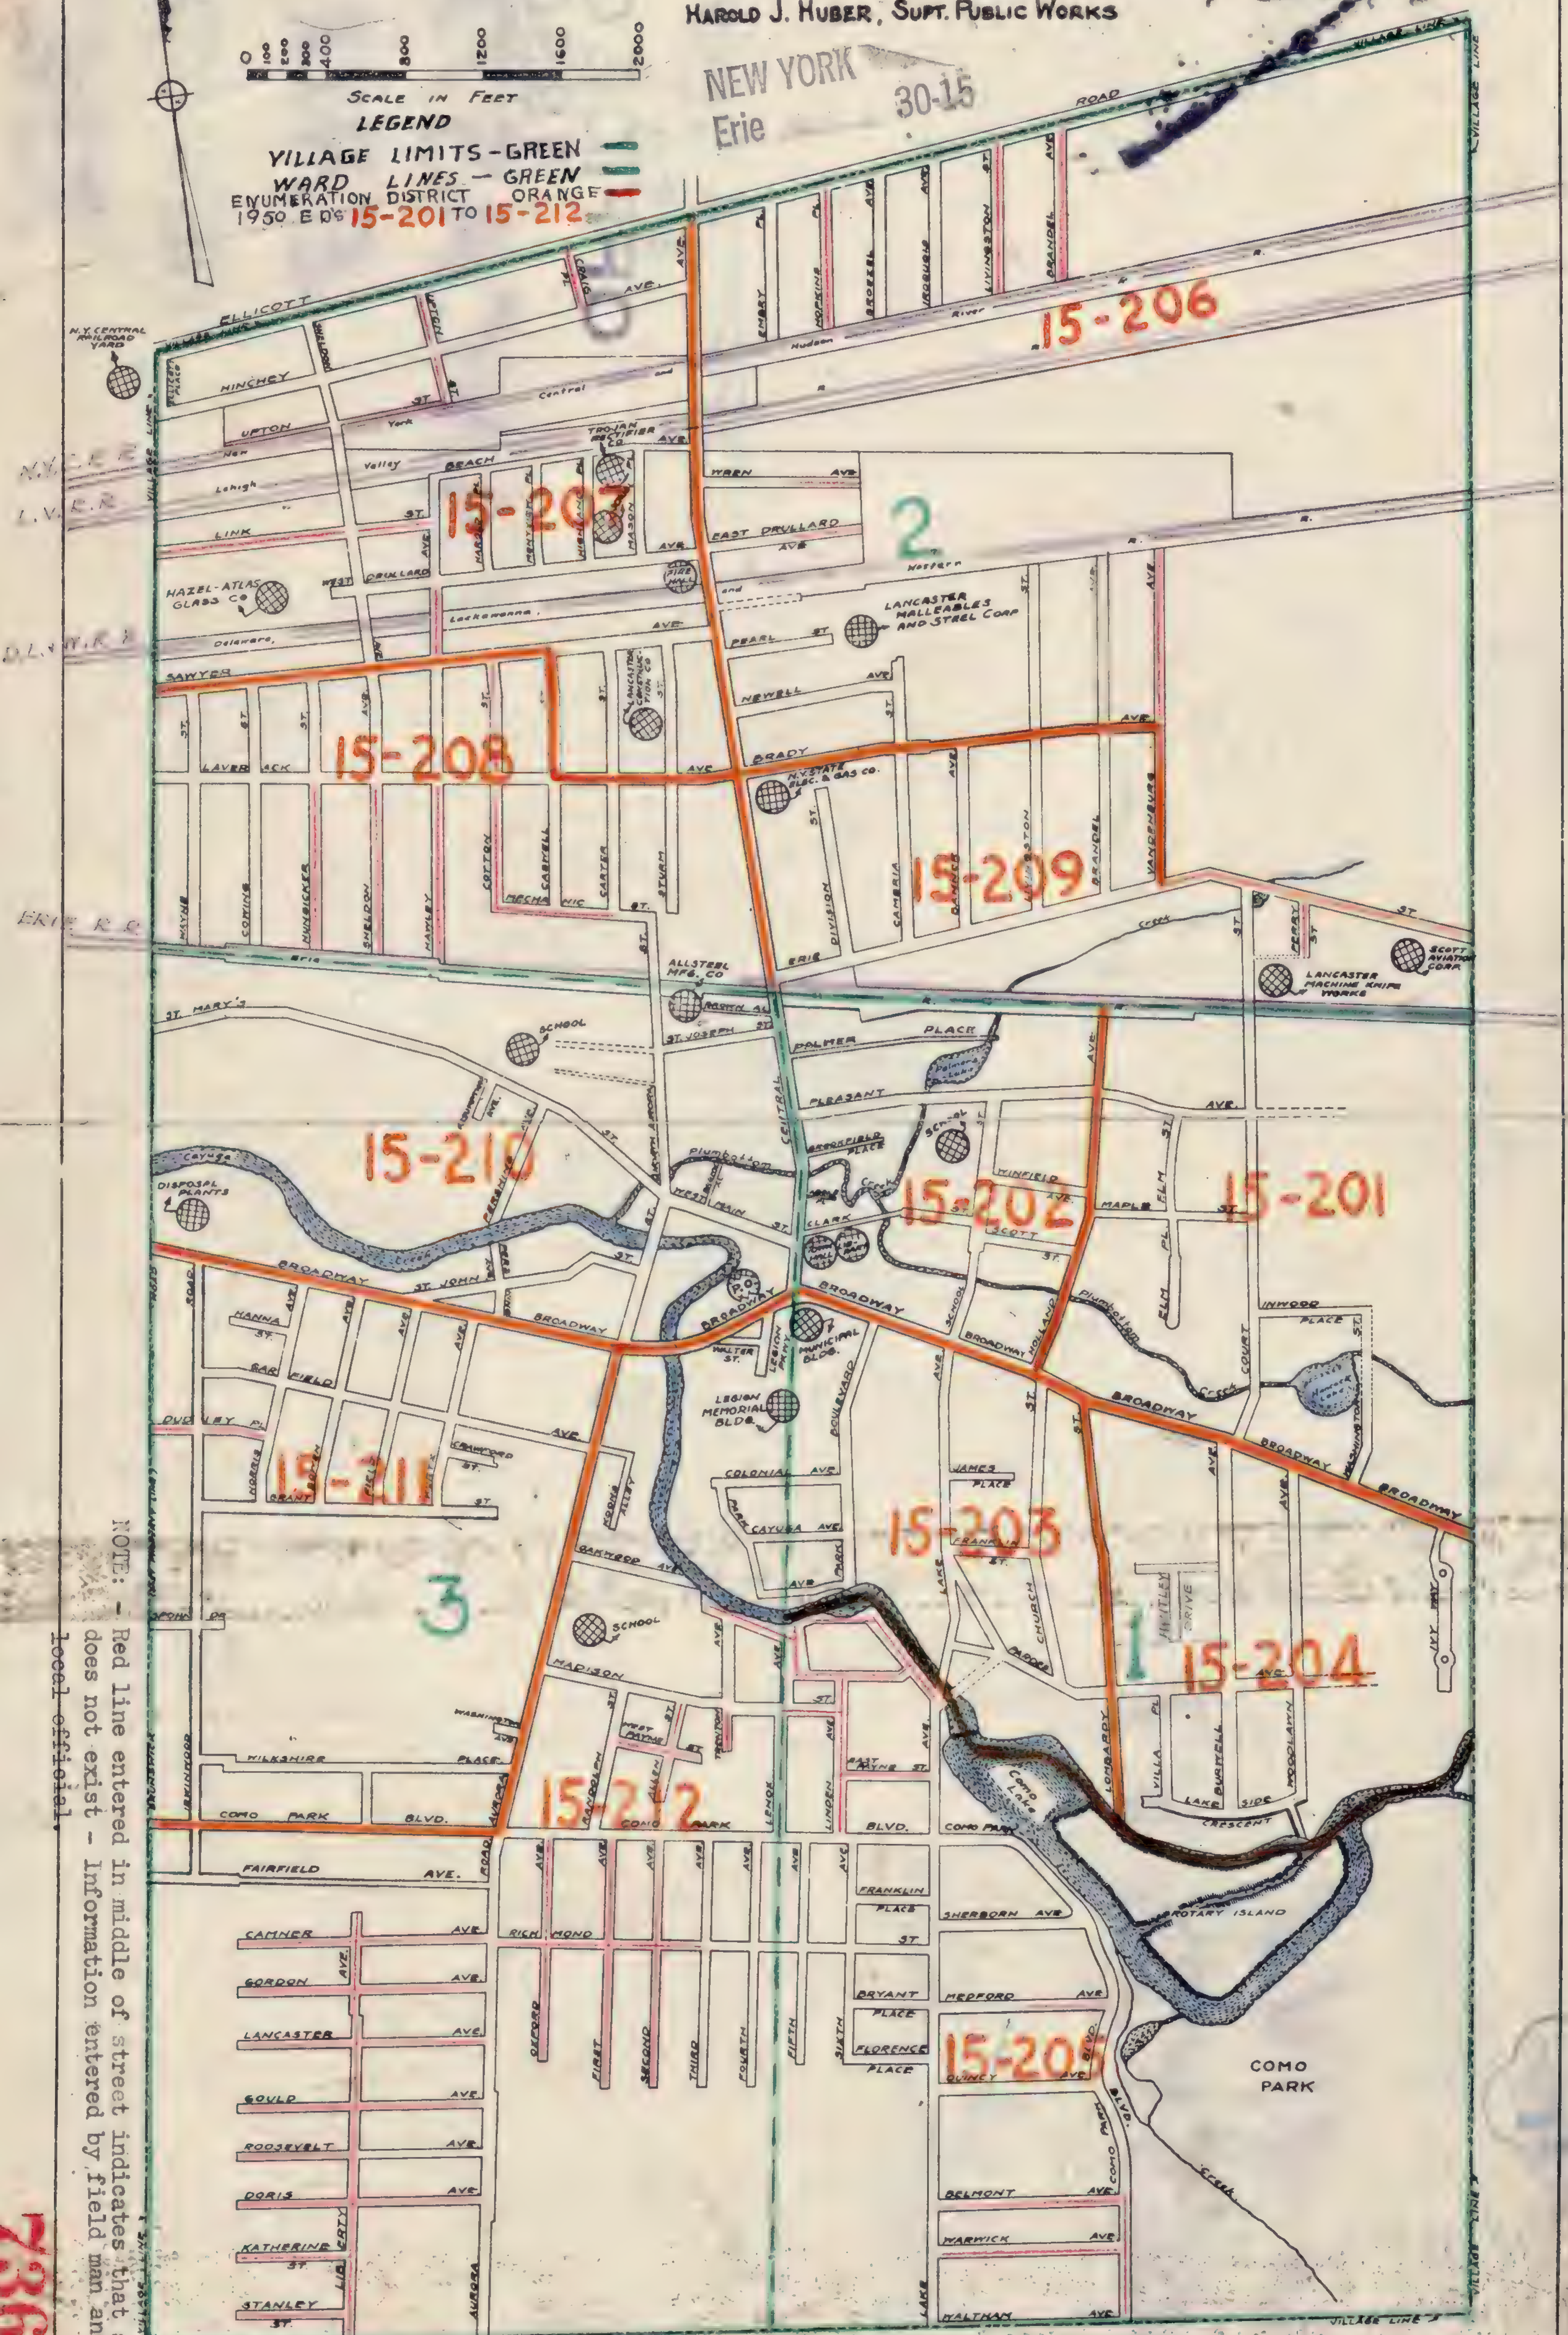

NOTE: - Red line entered in middle of street indicates that street does not exist - Information entered by field man and local official

73698

CERTIFICATION: I certify that the corporate limits (and ward boundaries) shown on this map are correct as of January 1st, 1948.
(Signed) Harold J Huber
Harold J. Huber, Supt. Public Works.

OFFICE COPY 1950

1950 OFFICE MAP

MAP OF THE TOWN OF ORCHARD PARK

ERIE COUNTY, N.Y.

Compiled by

ERIE COUNTY PLANNING BOARD

PUBLISHED AS OF JANUARY 1948

NOTE: THIS MAP IS COMPILED FROM DEEDS RECORDED IN THE ERIE COUNTY CLERKS OFFICE, SURVEYS AND OTHER AVAILABLED DATA.

77766

1950 E.D'S 15-226 TO 15-231

MCD (TOWN)____(RED)

INCORPORATED PLACE________(GREEN)

ENUMERATION DISTRICT________(ORANGE)

ENTIRELY WITHIN BUFFALO URBANIZED AREA

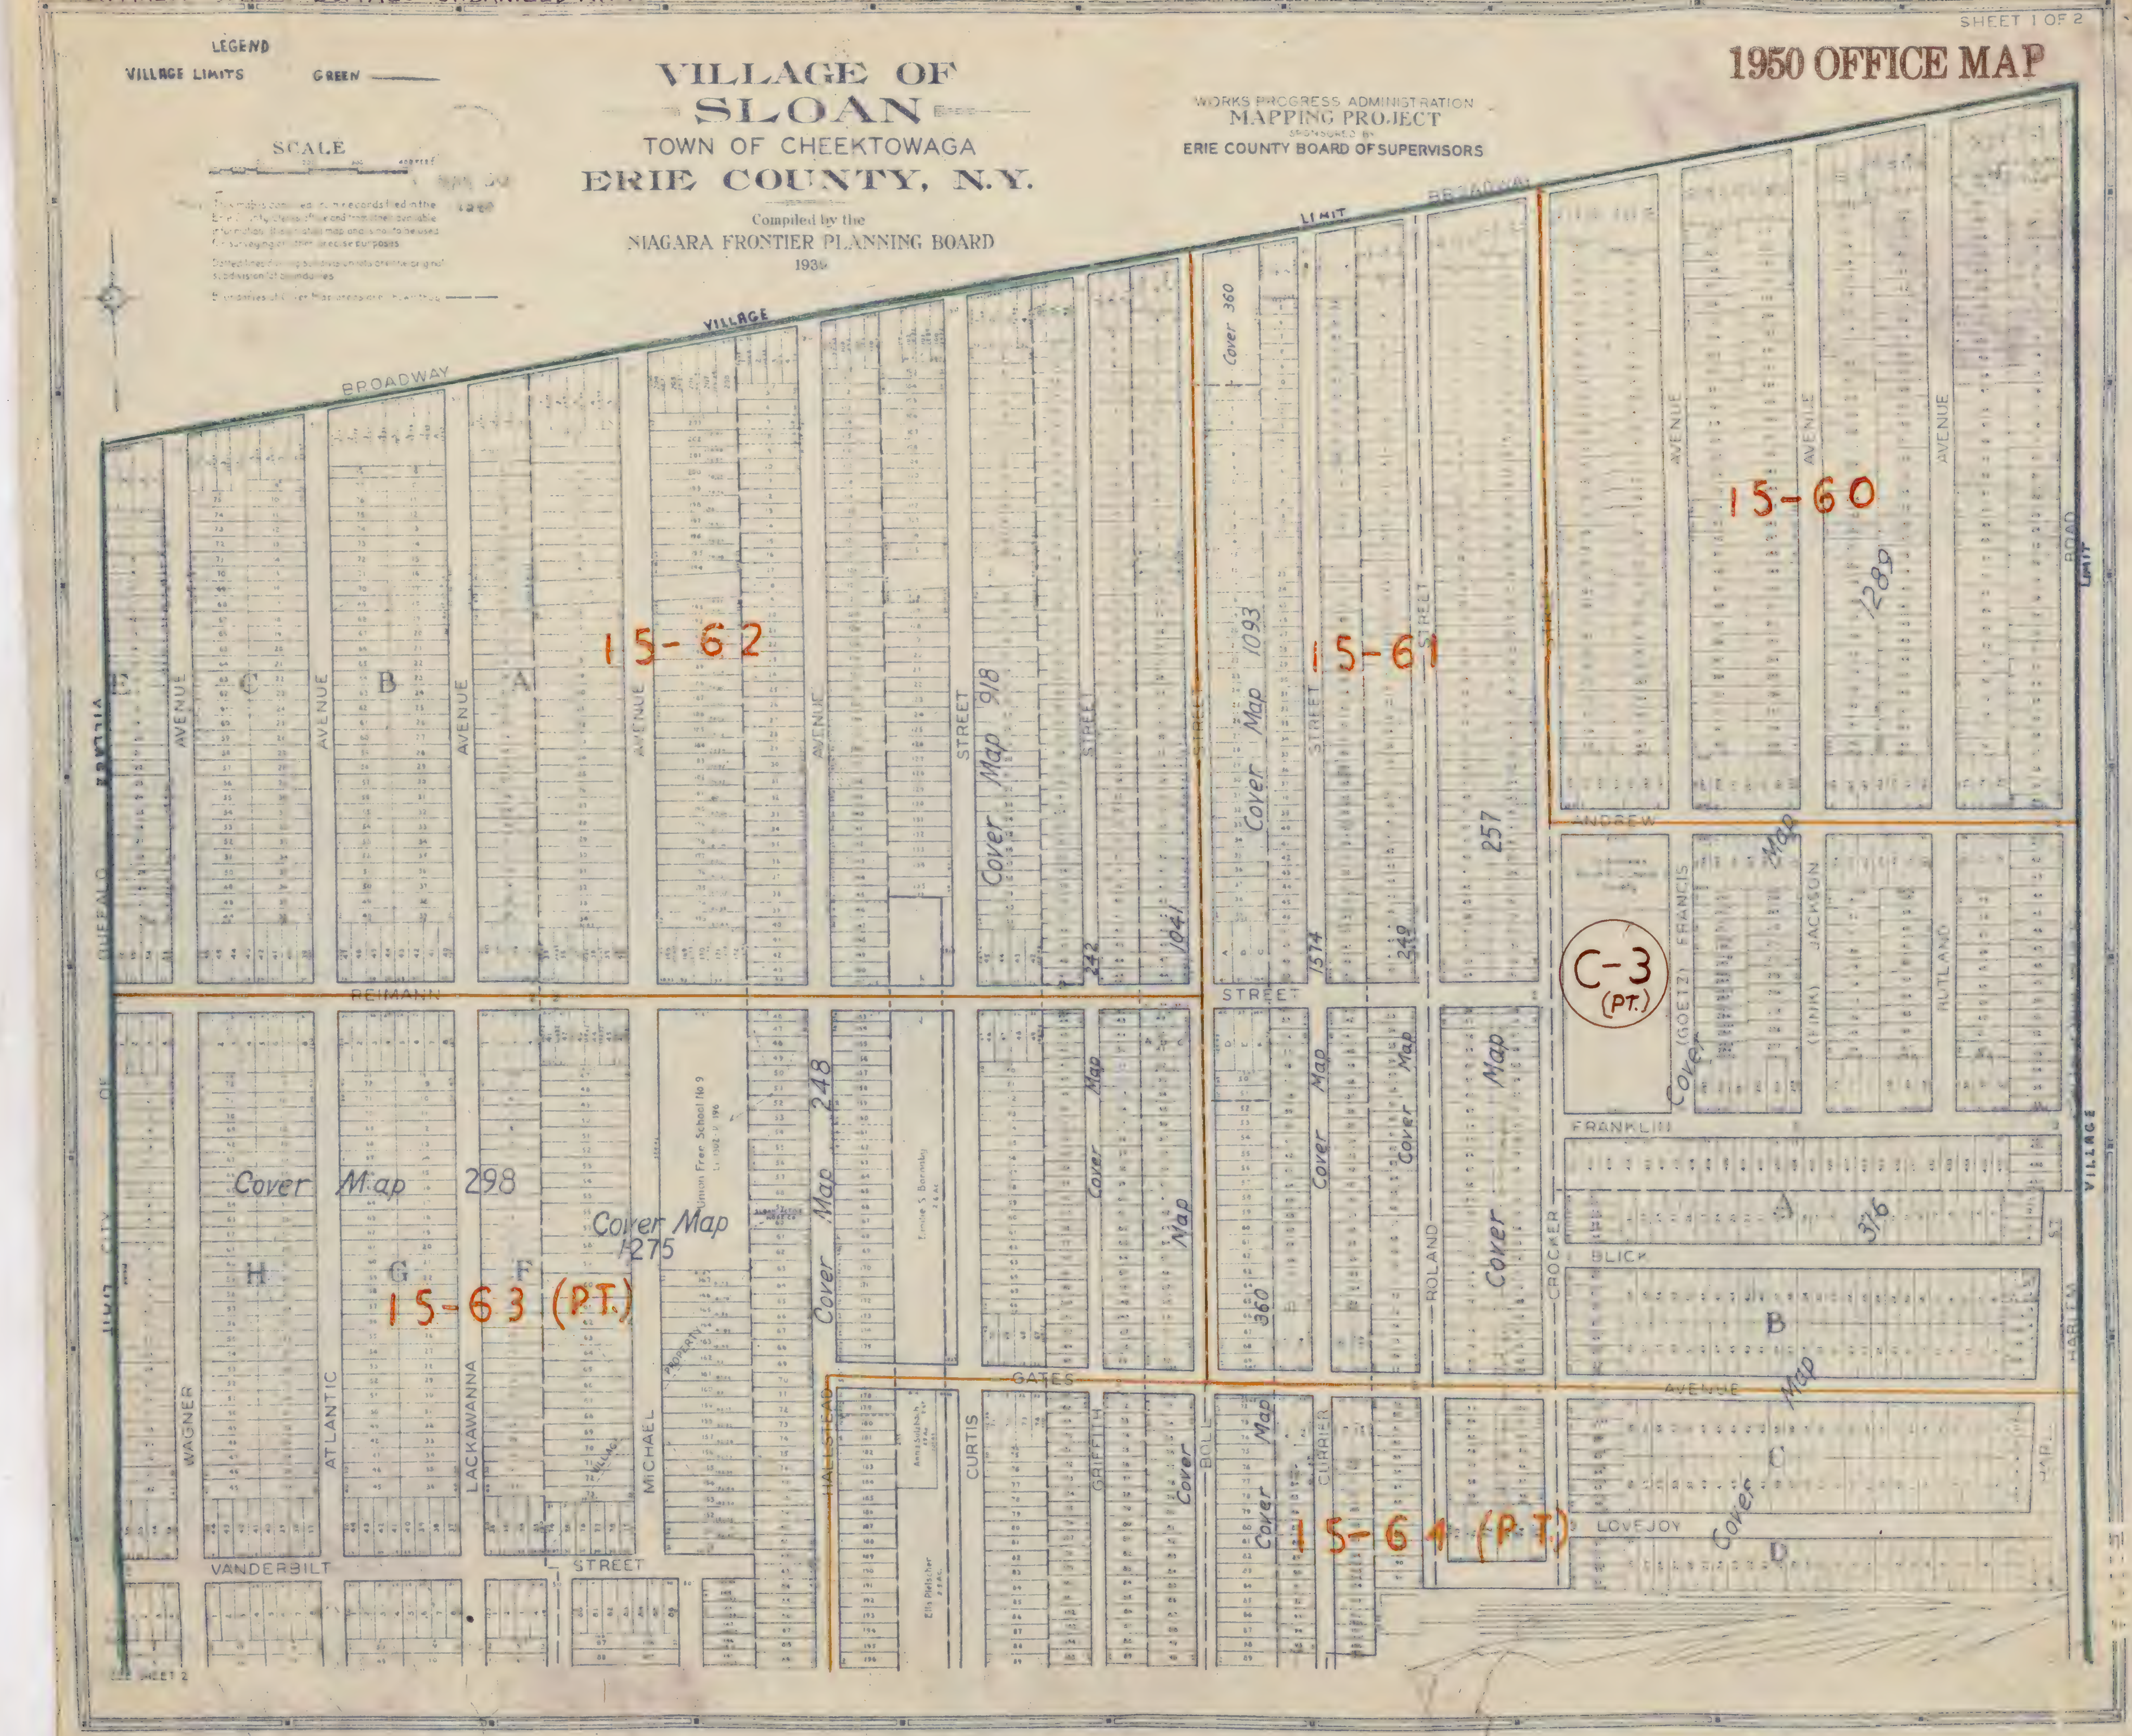

VILLAGE OF SLOAN

TOWN OF CHEEKTOWAGA

ERIE COUNTY, N.Y.

Compiled by the
NIAGARA FRONTIER PLANNING BOARD
1939

WORKS PROGRESS ADMINISTRATION
MAPPING PROJECT
SPONSORED BY
ERIE COUNTY BOARD OF SUPERVISORS

SHEET 1 OF 2

1950 OFFICE MAP

LEGEND

VILLAGE LIMITS GREEN ———

DUPLICATE COPY OF ORIGINAL 1950 OFFICE MAP PREPARED BY-
VERIFIED TO ORIGINAL 1950 OFFICE MAP AND E.D. DESCRIPTIONS BY-
DATE COPY WAS MADE - MAY 21, 1951

1950 E.D'S 15-60 TO 15-64
CORPORATE LIMITS & (GREEN) —
ENUMERATION DISTRICT (ORANGE) —
CENSUS TRACT C-3 (BROWN)

7369

73697

ENTIRELY WITHIN BUFFALO URBANIZED AREA

OFFICE COPY 1950

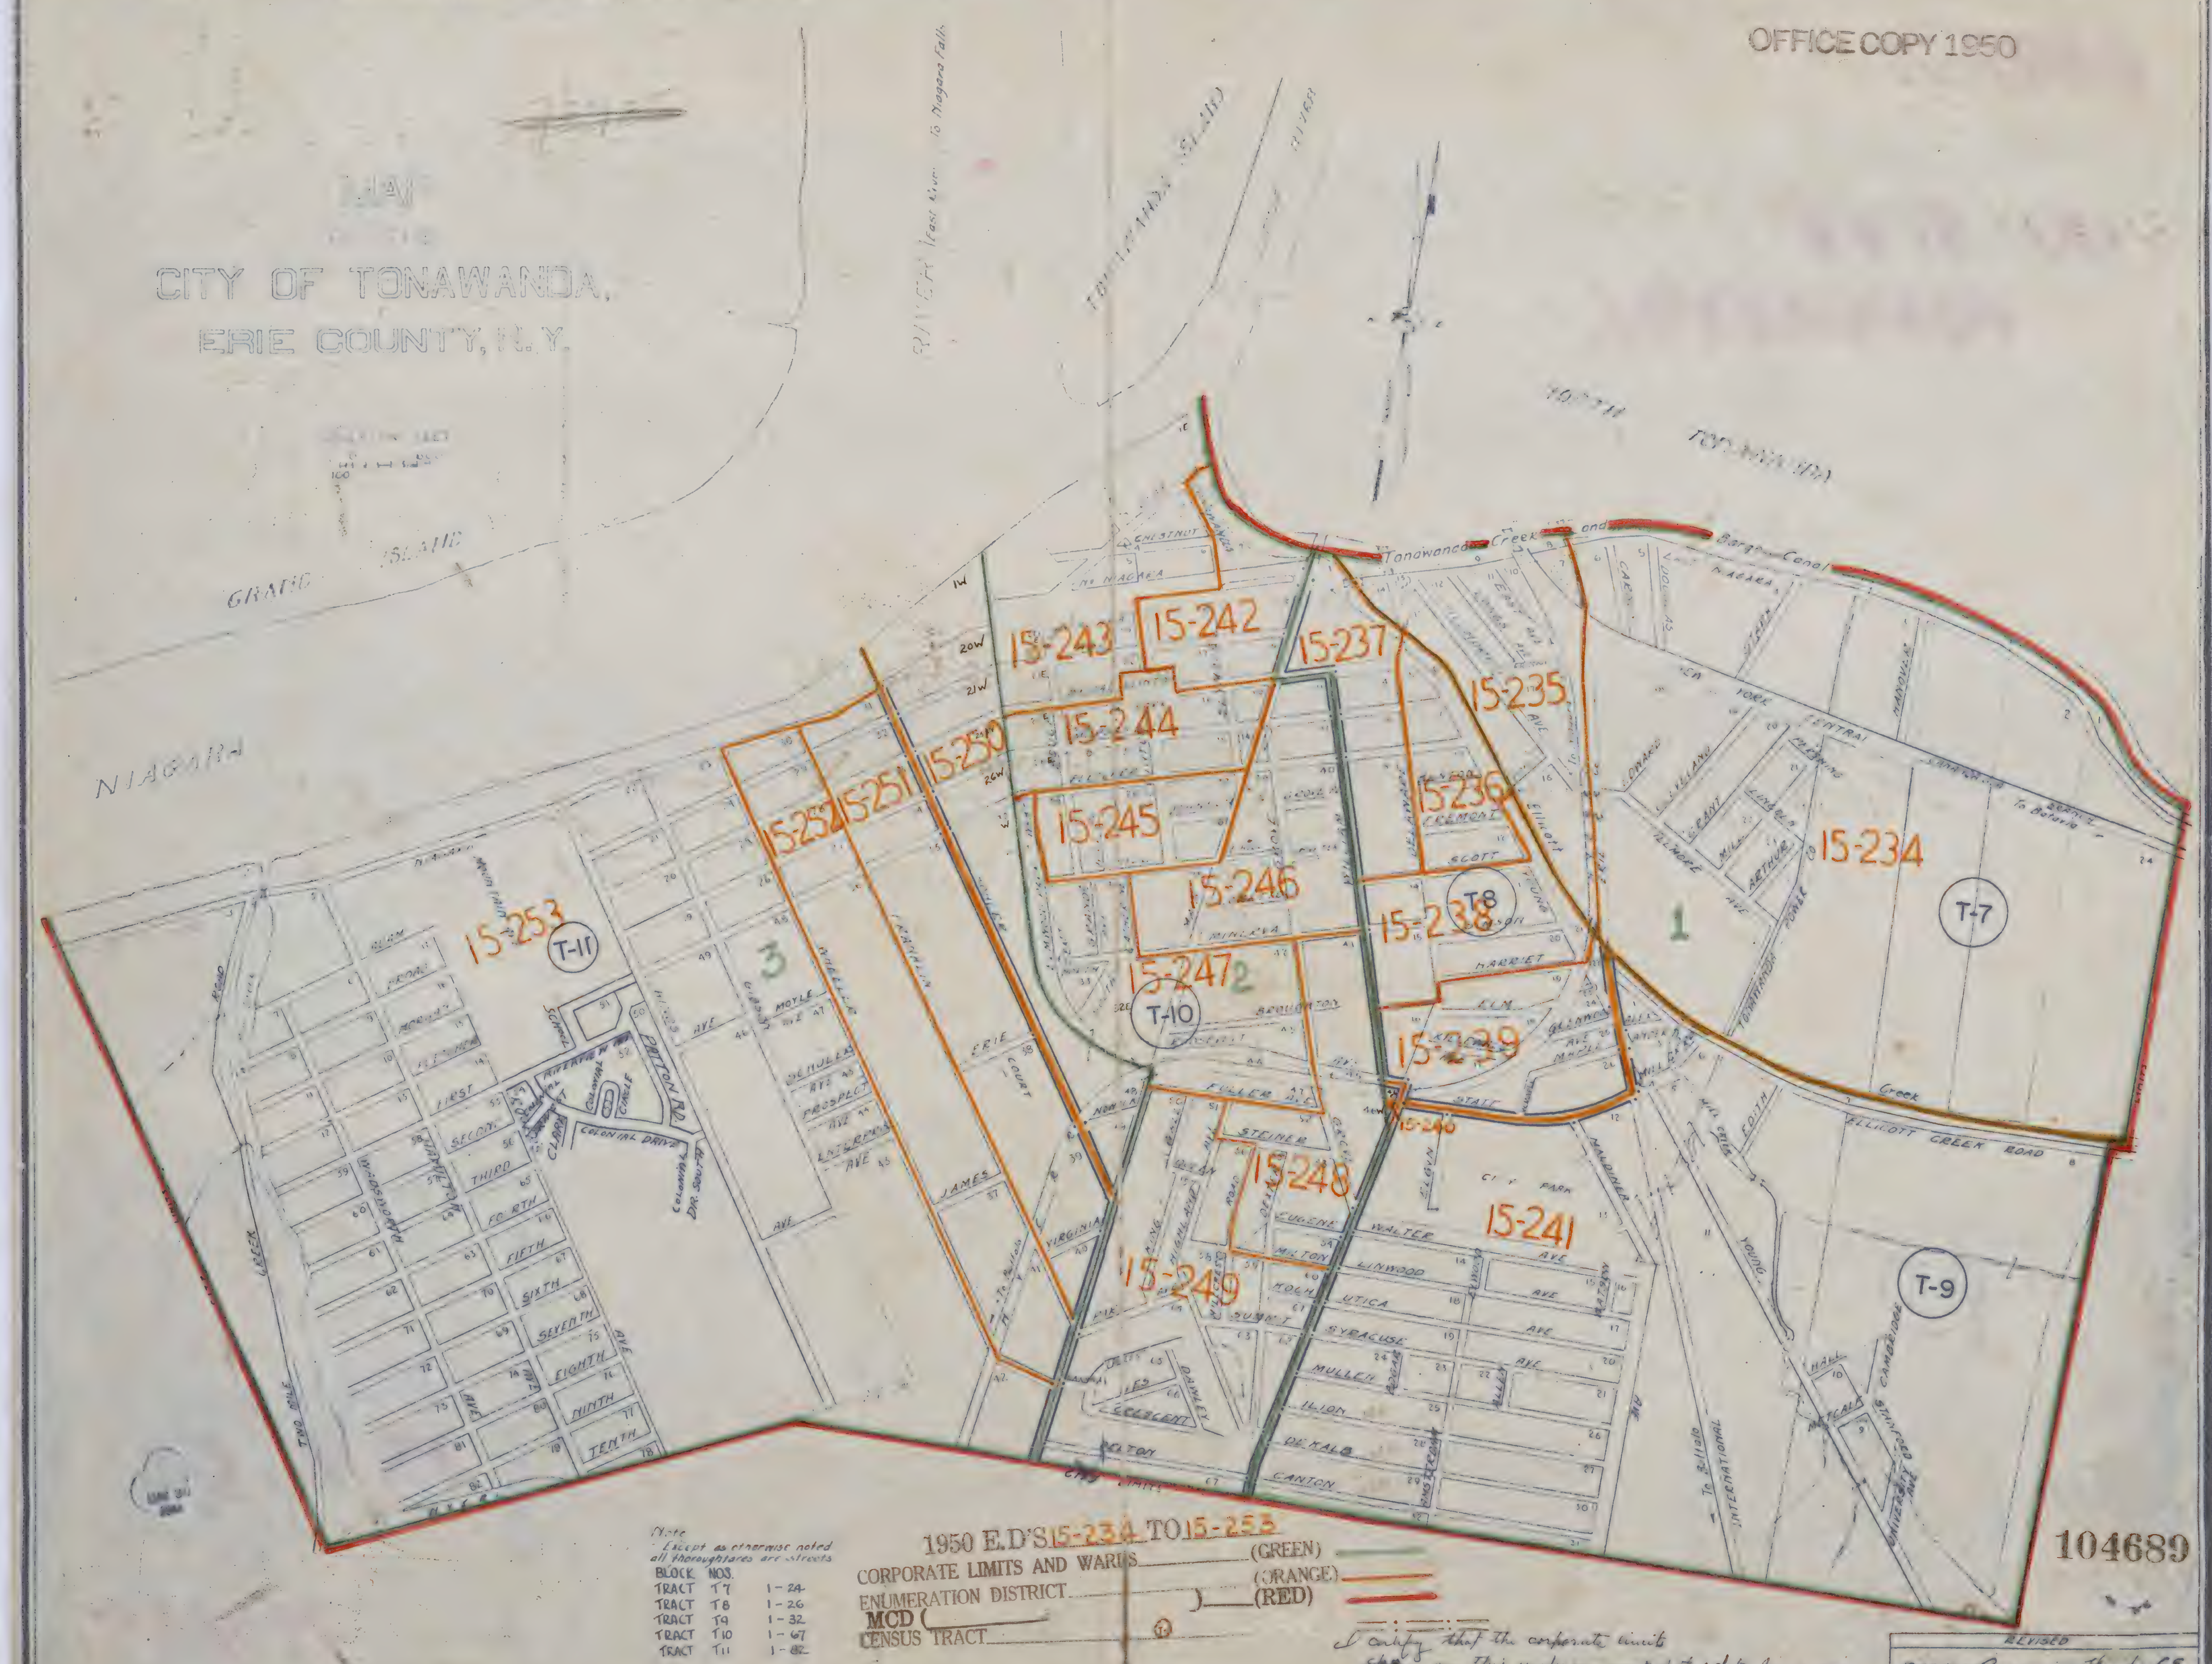

Note
- Except as otherwise noted all thoroughfares are streets

BLOCK	NOS.	
TRACT	T7	1 - 24
TRACT	T8	1 - 26
TRACT	T9	1 - 32
TRACT	T10	1 - 67
TRACT	T11	1 - 82

1950 E.D'S 15-234 TO 15-253

CORPORATE LIMITS AND WARDS (GREEN)

ENUMERATION DISTRICT (ORANGE)

MCD ( ) (RED)

CENSUS TRACT ①

I certify that the corporate limits shown on this map are correct of this date: Nov. 3, 1948
Benjamin Hinkley City Engineer.

104689

REVISED
1944 by: Benjamin Hinkley C.E.
1954 by: Benjamin Hinkley C.E.

A

B

PARTLY WITHIN BUFFALO URBANIZED AREA

1950 OFFICE MAP

MAP OF
THE TOWN OF
TONAWANDA
ERIE COUNTY, N.Y.

Compiled by
ERIE COUNTY PLANNING BOARD

ENTIRE TOWN in TWP. 12—RG. 8

SPECIAL ENUMERATION AREAS

15-298 MOUNT SAINT MARY—PROVINCIAL HOUSE AND NOVITIATE OF THE SISTERS OF ST. MARY OF NAMUR, INC.

• LEGEND •
- TOWNSHIP & RANGE LINE
- FARM or GREAT LOT LINE
- PROPERTY LINE
- STATE HIGHWAY
- COUNTY HIGHWAY
- TOWN HIGHWAY
- RAILROADS
- WATER LINE
- ELECTRIC LINE
- POWER LINE
- PARKS
- CITY OR VILLAGE LINE

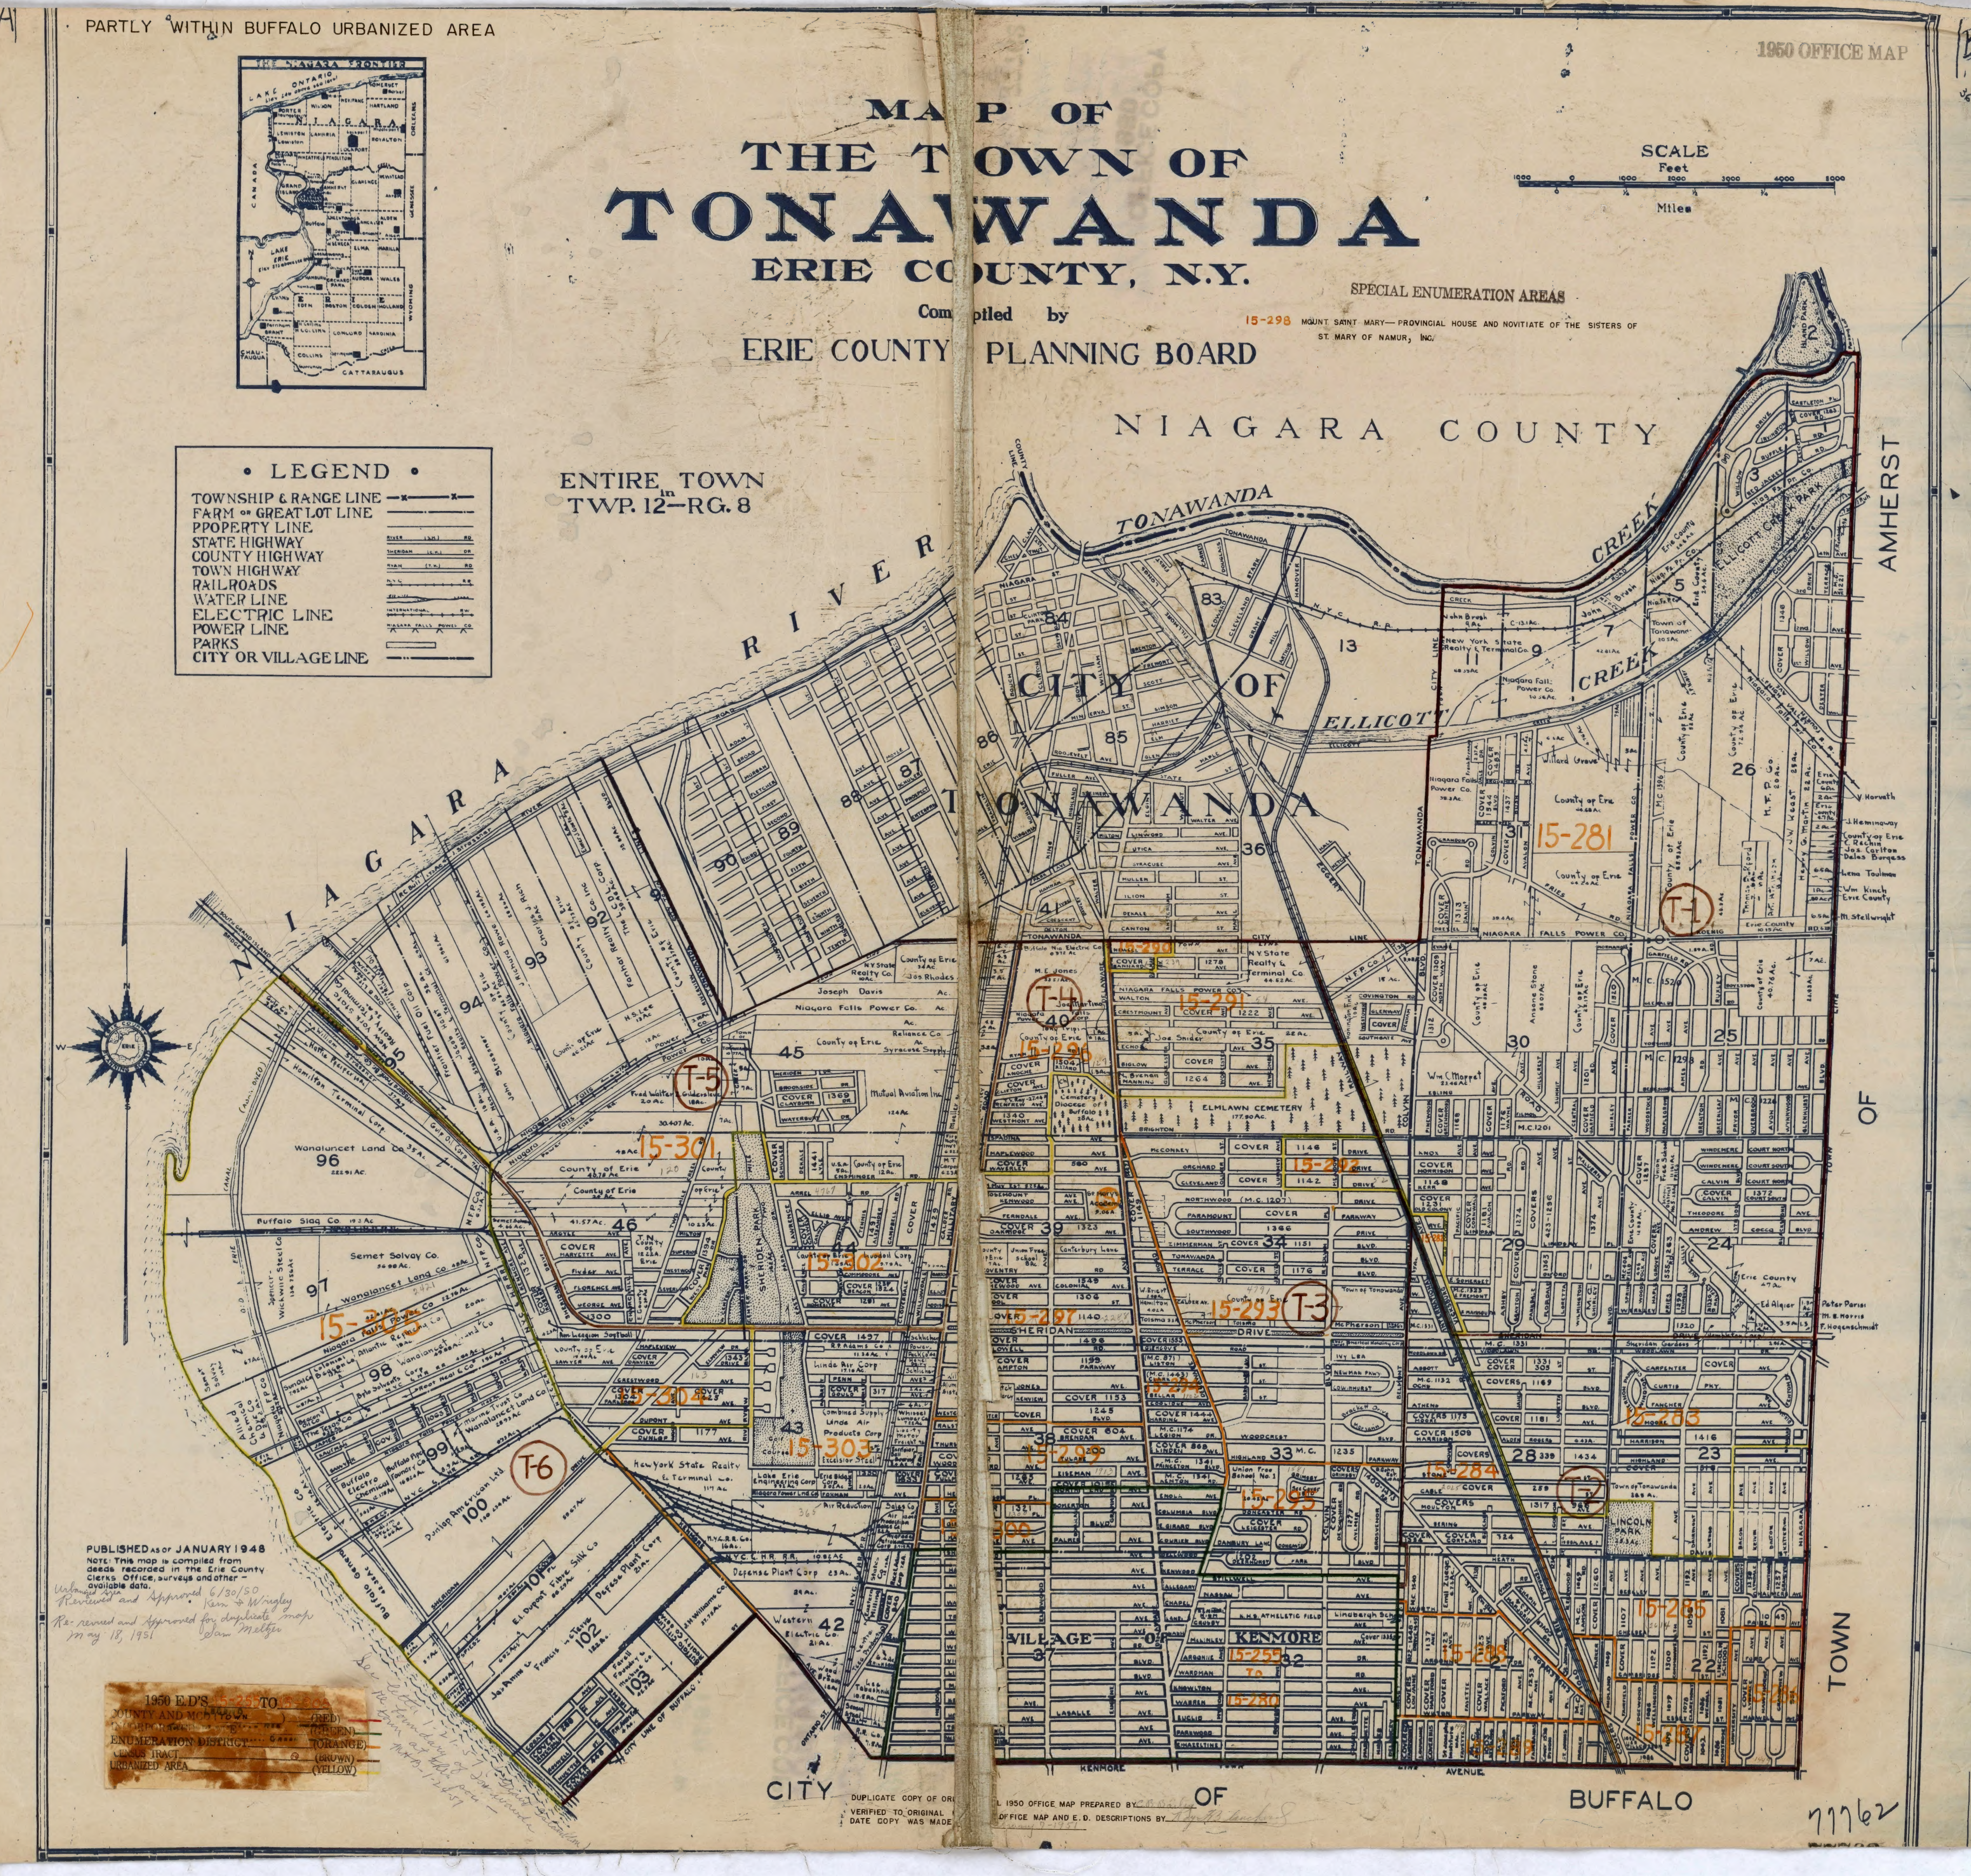

PUBLISHED AS OF JANUARY 1948

NOTE: This map is compiled from deeds recorded in the Erie County Clerks Office, surveys and other – available data.

Urbanized Area Reviewed and Approved 6/30/50. Kern & Wrigley

Re-reviewed and Approved for duplicate map May 18, 1951 Sam Meltzer

See letter 1-21-57 (Grand Island Lim) re boundary of Tonawanda town at this point — M.H.B. 1-24-57

1950 E.D'S 15-255 TO 15-305
COUNTY AND MCD (TOWN) ______ (RED)
INCORPORATED PLACE ______ (GREEN)
ENUMERATION DISTRICT ______ (ORANGE)
CENSUS TRACT ______ (BROWN)
URBANIZED AREA ______ (YELLOW)

DUPLICATE COPY OF ORI[illegible]L 1950 OFFICE MAP PREPARED BY C.B. Bailey
VERIFIED TO ORIGINAL [illegible] OFFICE MAP AND E.D. DESCRIPTIONS BY Roy H. Blanchard
DATE COPY WAS MADE [illegible]ruary 7-1951

77762

PARTLY WITHIN BUFFALO URBANIZED AREA

1950 OFFICE MAP

MAP OF
THE TOWN OF
WEST SENECA
ERIE COUNTY, N.Y.

Reproduced by
ERIE COUNTY PLANNING BOARD

77767

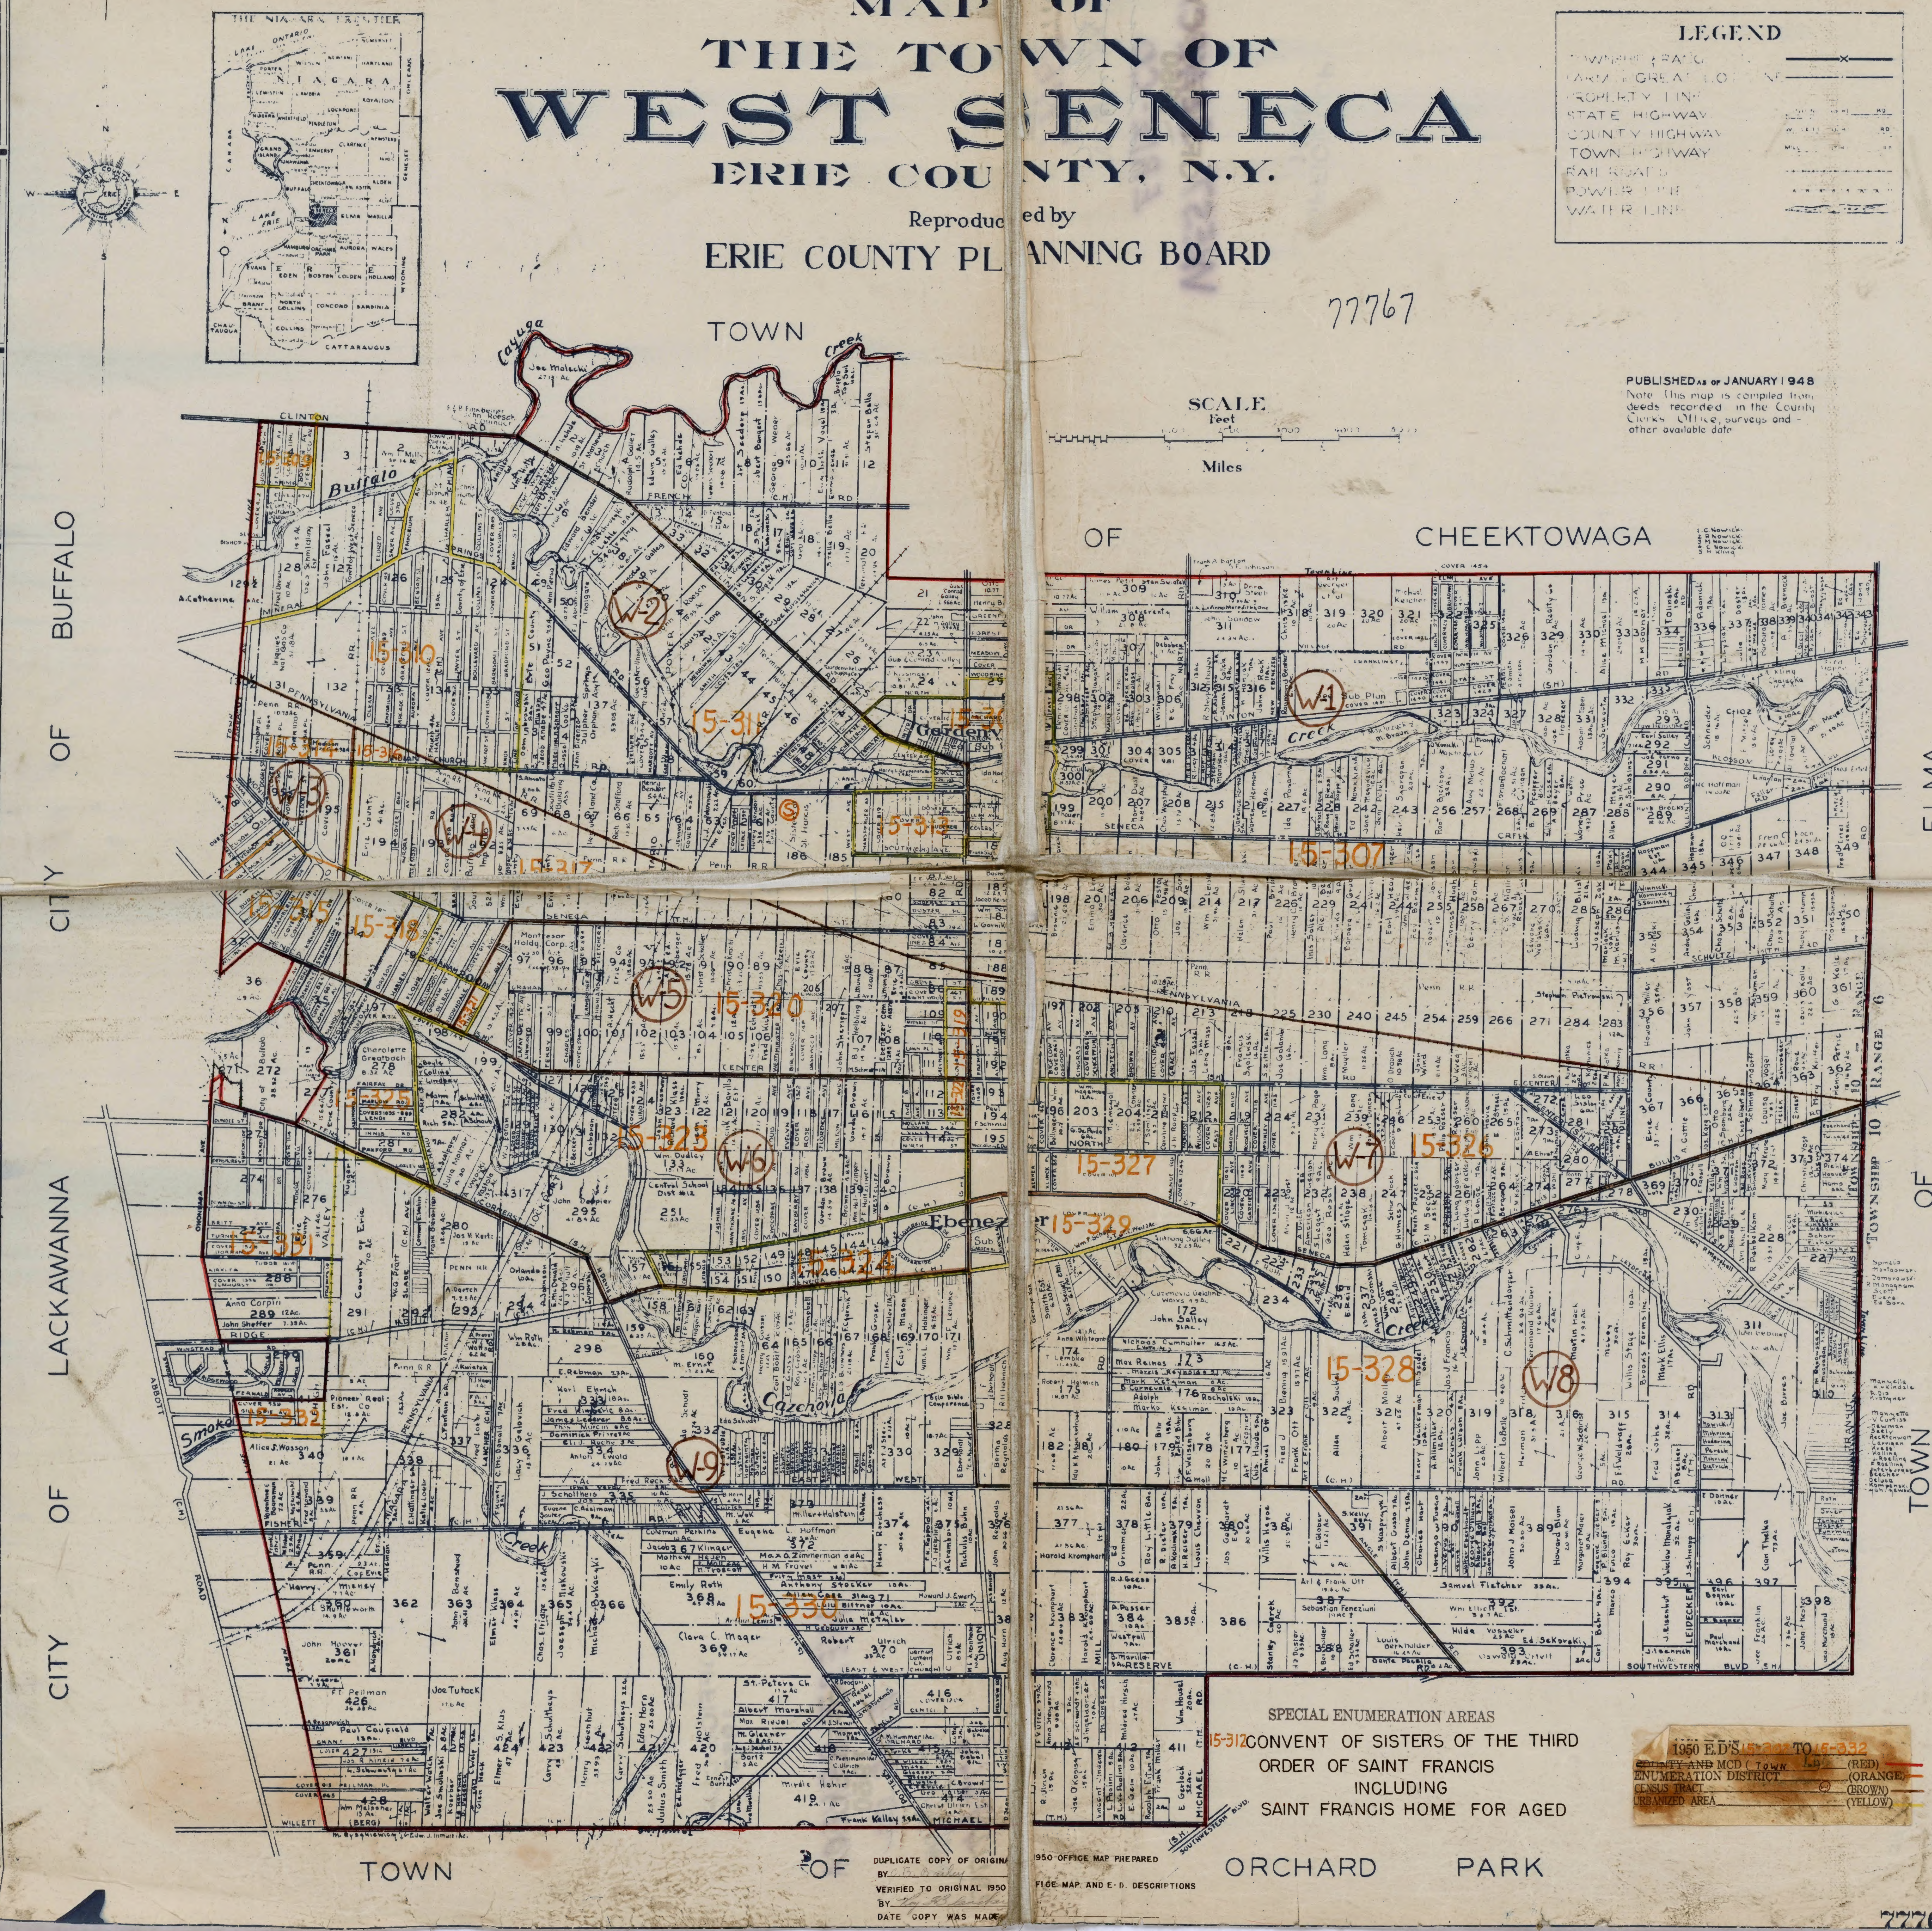

PUBLISHED AS OF JANUARY 1948
Note This map is compiled from deeds recorded in the County Clerk's Office, surveys and other available data

SPECIAL ENUMERATION AREAS

15-312 CONVENT OF SISTERS OF THE THIRD ORDER OF SAINT FRANCIS INCLUDING SAINT FRANCIS HOME FOR AGED

1950 E.D'S 15-307 TO 15-332
~~COUNTY AND~~ MCD (TOWN) (RED)
ENUMERATION DISTRICT (ORANGE)
CENSUS TRACT (BROWN)
URBANIZED AREA (YELLOW)

DUPLICATE COPY OF ORIGINAL 1950 OFFICE MAP PREPARED
BY C. B. Bailey
VERIFIED TO ORIGINAL 1950 OFFICE MAP AND E. D. DESCRIPTIONS
BY
DATE COPY WAS MADE

Urbanized Area boundary reviewed and approved 6/30/50 Kern & Wrigley

re-reviewed and approved on duplicate map May 18, 1951 Sam Meltzer

77767

77767

ENTIRELY WITHIN BUFFALO URBANIZED AREA

73731

OFFICE COPY 1950

VILLAGE OF
WILLIAMSVILLE
ERIE COUNTY, N.Y.

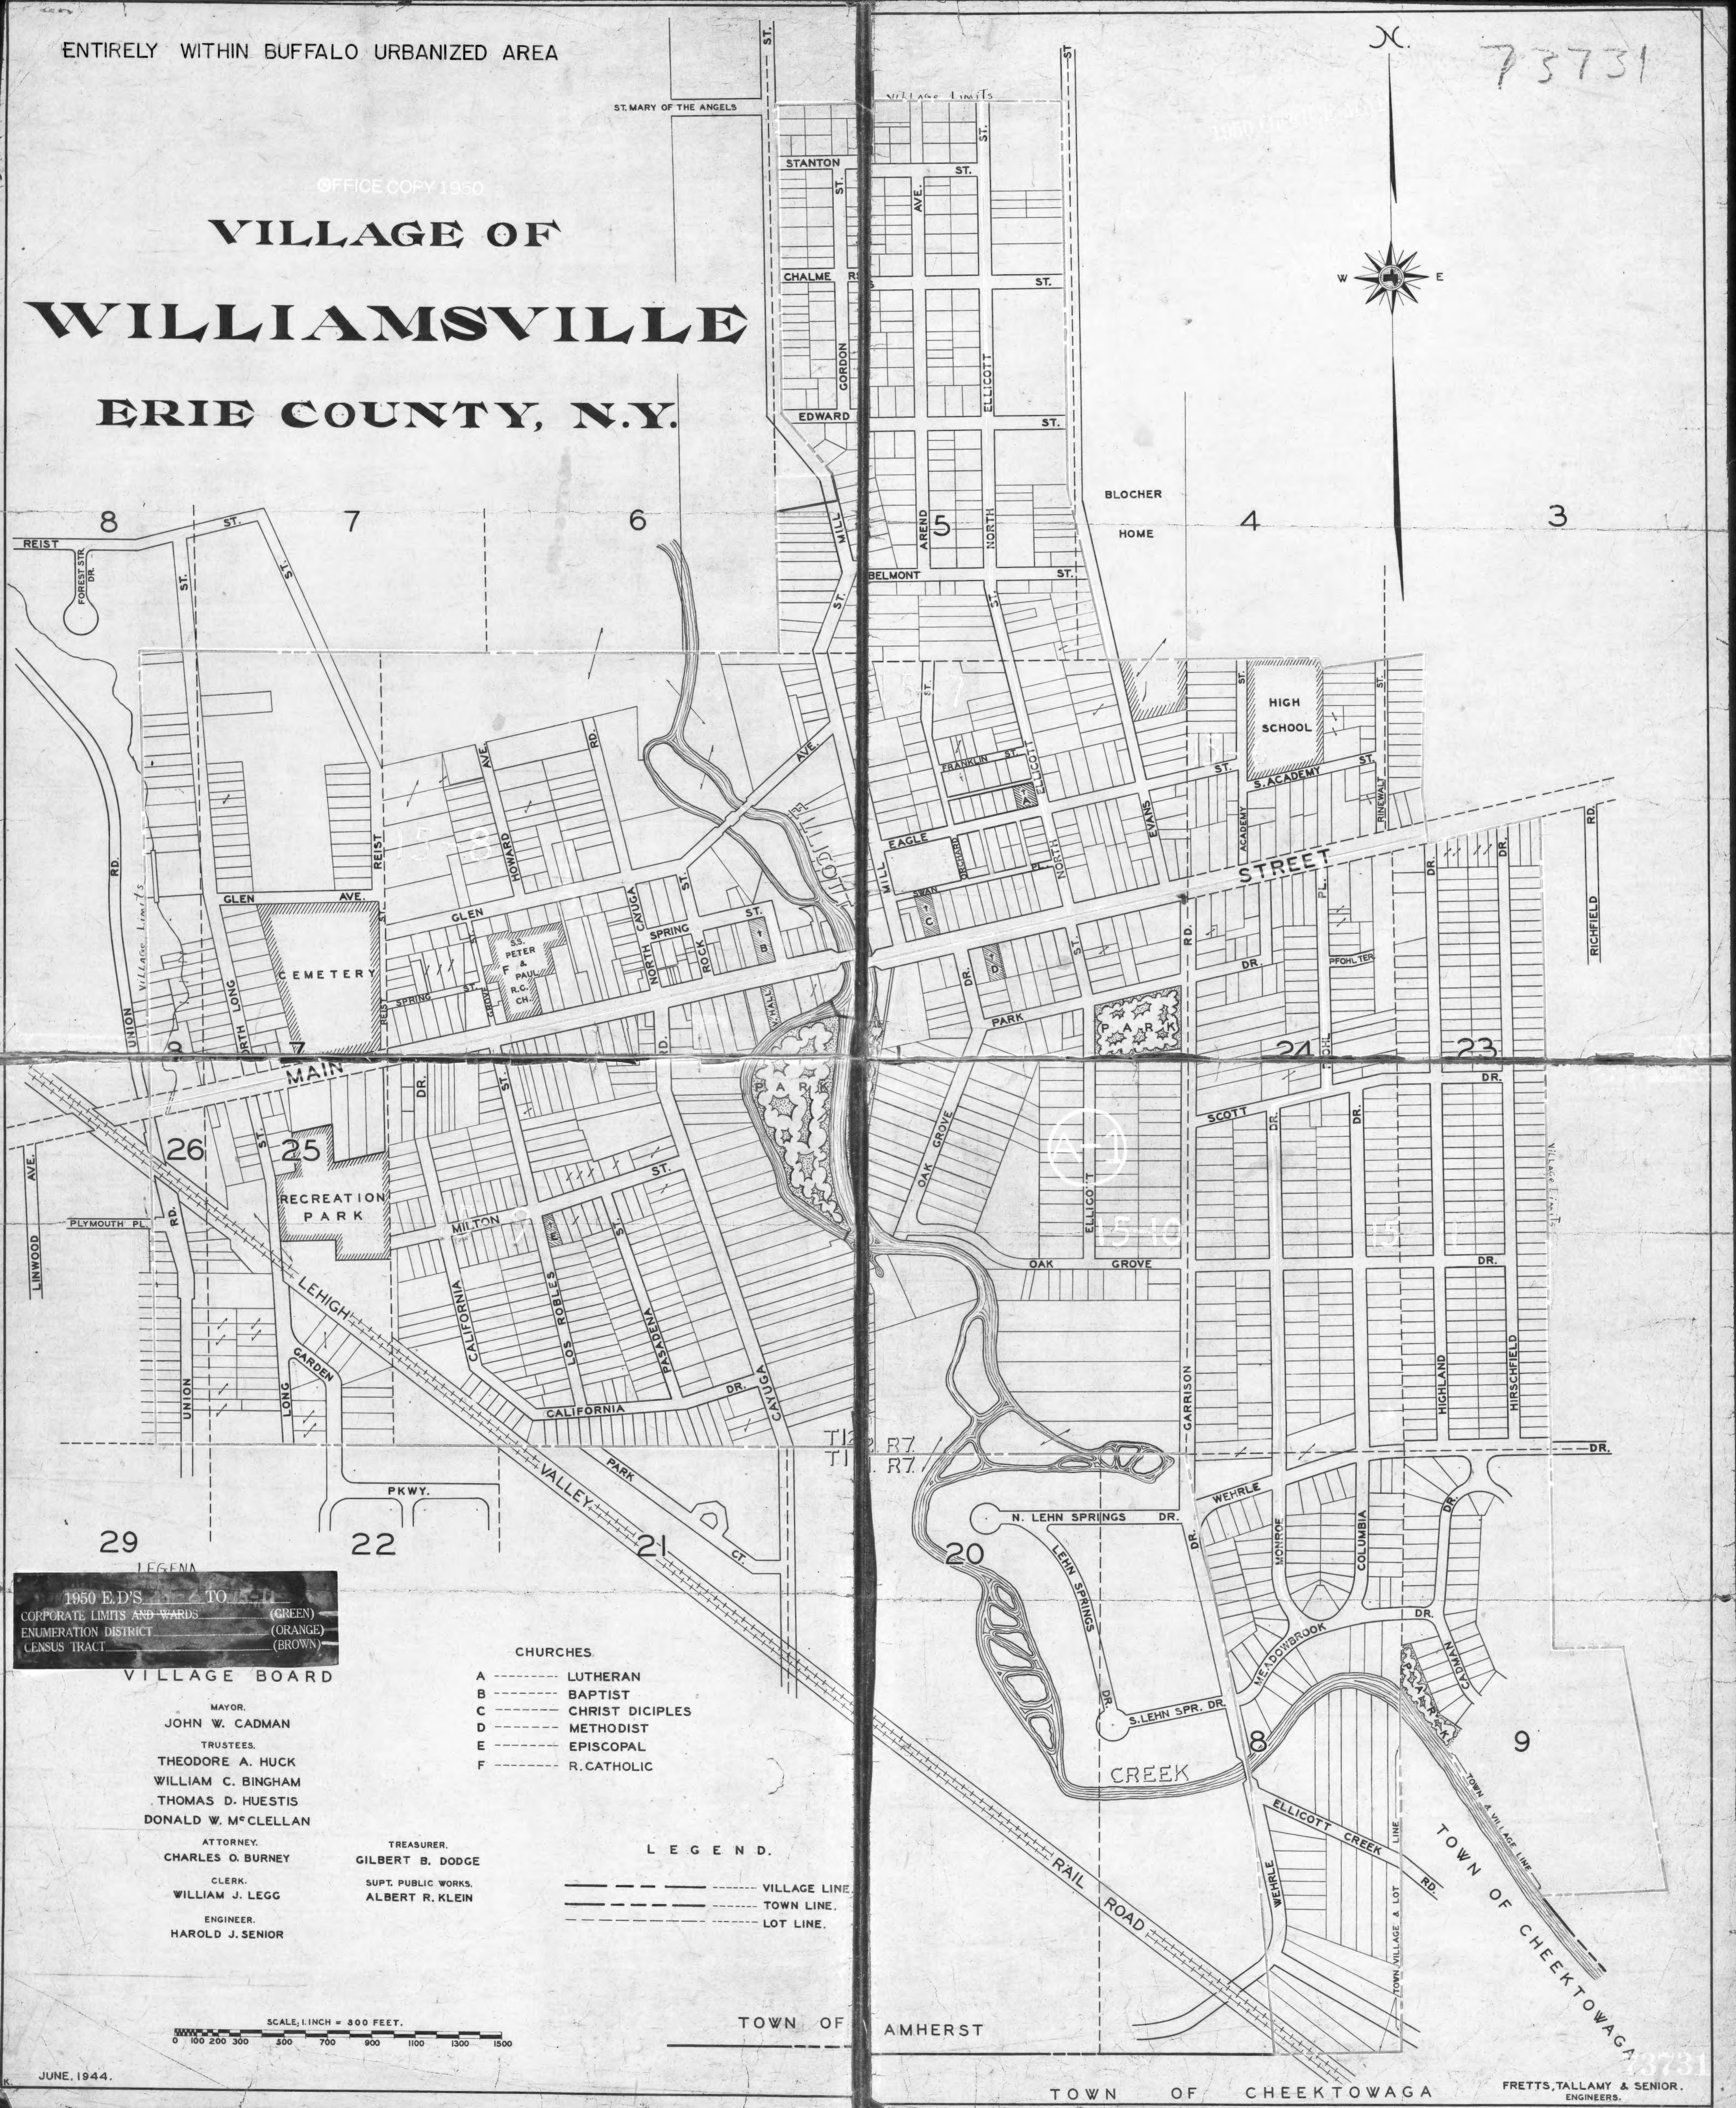

LEGEND

1950 E.D'S 15-6 TO 15-11
CORPORATE LIMITS ~~AND WARDS~~ (GREEN)
ENUMERATION DISTRICT (ORANGE)
CENSUS TRACT (BROWN)

VILLAGE BOARD

MAYOR.
JOHN W. CADMAN

TRUSTEES.
THEODORE A. HUCK
WILLIAM C. BINGHAM
THOMAS D. HUESTIS
DONALD W. McCLELLAN

ATTORNEY.
CHARLES O. BURNEY

CLERK.
WILLIAM J. LEGG

ENGINEER.
HAROLD J. SENIOR

TREASURER.
GILBERT B. DODGE

SUPT. PUBLIC WORKS.
ALBERT R. KLEIN

CHURCHES

A --------- LUTHERAN
B --------- BAPTIST
C --------- CHRIST DICIPLES
D --------- METHODIST
E --------- EPISCOPAL
F --------- R. CATHOLIC

LEGEND.

------- VILLAGE LINE.
------- TOWN LINE.
------- LOT LINE.

SCALE; 1 INCH = 300 FEET.
0 100 200 300 500 700 900 1100 1300 1500

JUNE. 1944.

FRETTS, TALLAMY & SENIOR.
ENGINEERS.

4191.

73731

ENTIRELY WITHIN BUFFALO URBANIZED AREA

OFFICE COPY 1950

VILLAGE OF
WILLIAMSVILLE
ERIE COUNTY, N.Y.

1950 OFFICE MAP

73731

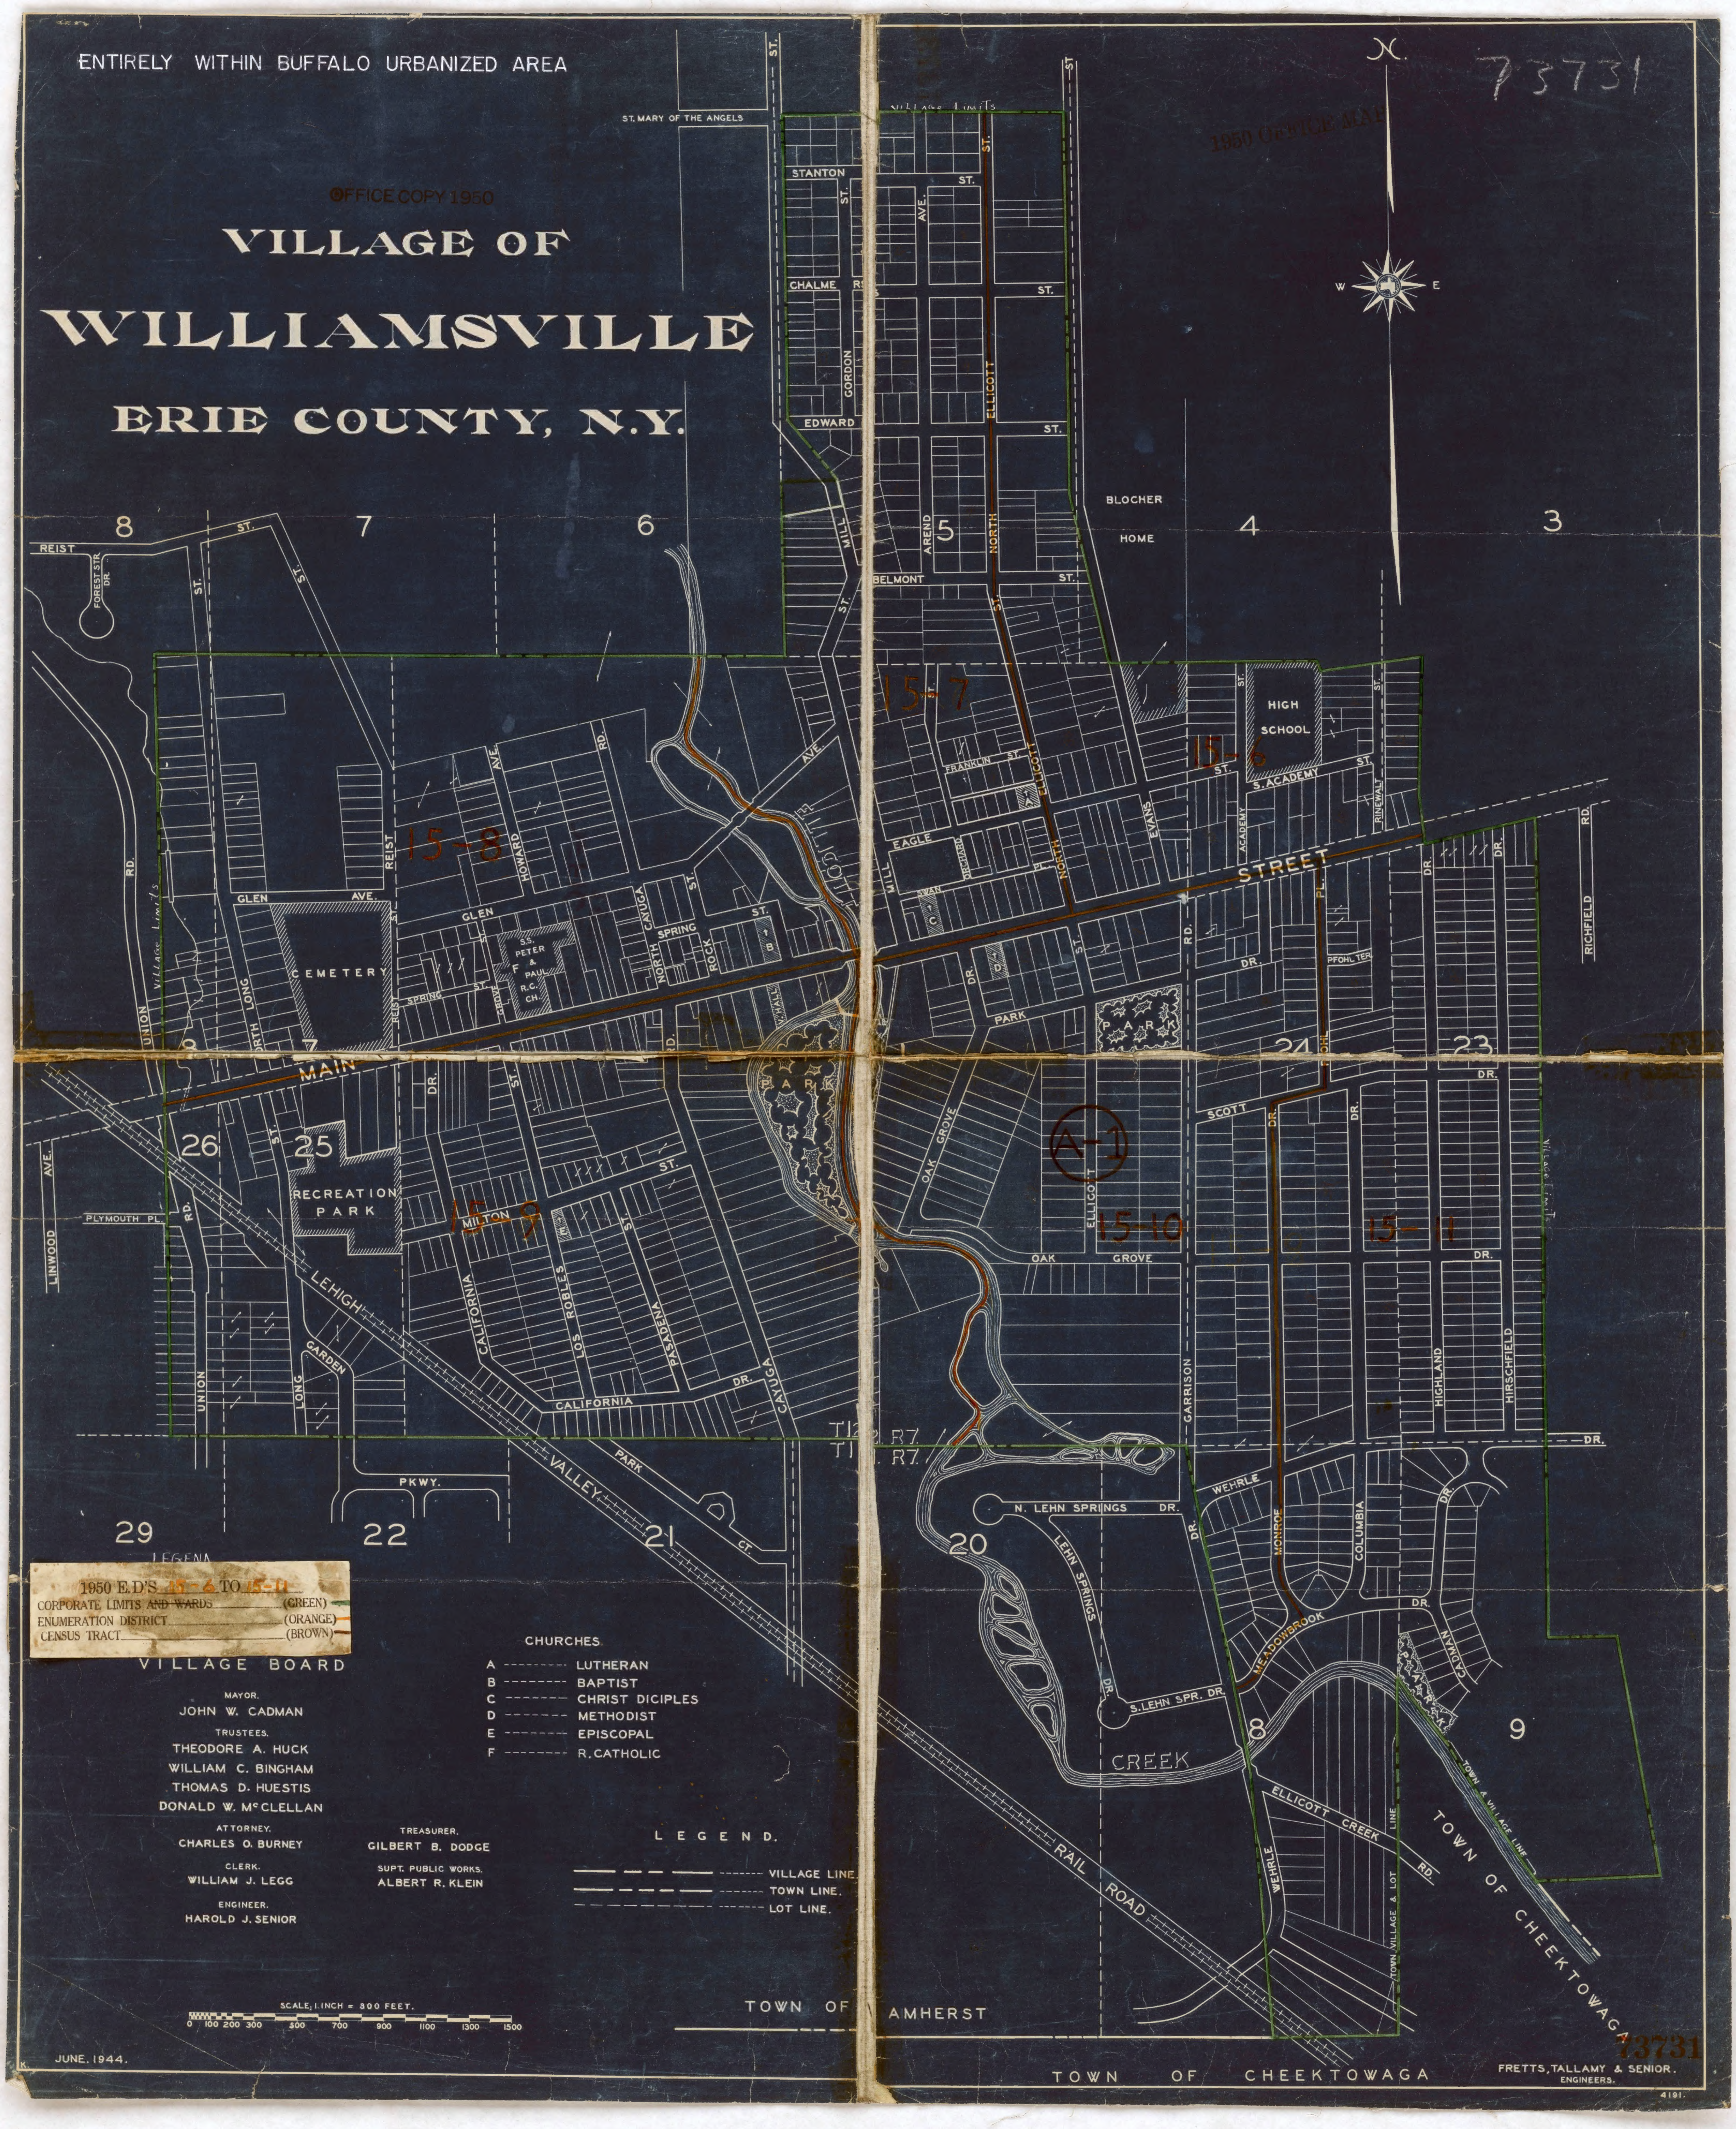

1950 E.D'S 15-6 TO 15-11

CORPORATE LIMITS ~~AND WARDS~~	(GREEN)	🟩
ENUMERATION DISTRICT	(ORANGE)	🟧
CENSUS TRACT	(BROWN)	🟫

VILLAGE BOARD

MAYOR.
JOHN W. CADMAN

TRUSTEES.
THEODORE A. HUCK
WILLIAM C. BINGHAM
THOMAS D. HUESTIS
DONALD W. McCLELLAN

ATTORNEY.
CHARLES O. BURNEY

CLERK.
WILLIAM J. LEGG

ENGINEER.
HAROLD J. SENIOR

TREASURER.
GILBERT B. DODGE

SUPT. PUBLIC WORKS.
ALBERT R. KLEIN

CHURCHES

A	LUTHERAN
B	BAPTIST
C	CHRIST DICIPLES
D	METHODIST
E	EPISCOPAL
F	R. CATHOLIC

LEGEND.

▬ ‒ ‒ ▬	VILLAGE LINE.
▬ ‒ ‒ ‒ ▬	TOWN LINE.
‒ ‒ ‒ ‒	LOT LINE.

SCALE; 1 INCH = 300 FEET.
0 100 200 300 500 700 900 1100 1300 1500

JUNE. 1944.

FRETTS, TALLAMY & SENIOR.
ENGINEERS.

4191.

73731